


# Claim of Beneficial Use - Braun - Transfer T-13066

Township 12S, Range 4W, W.M.

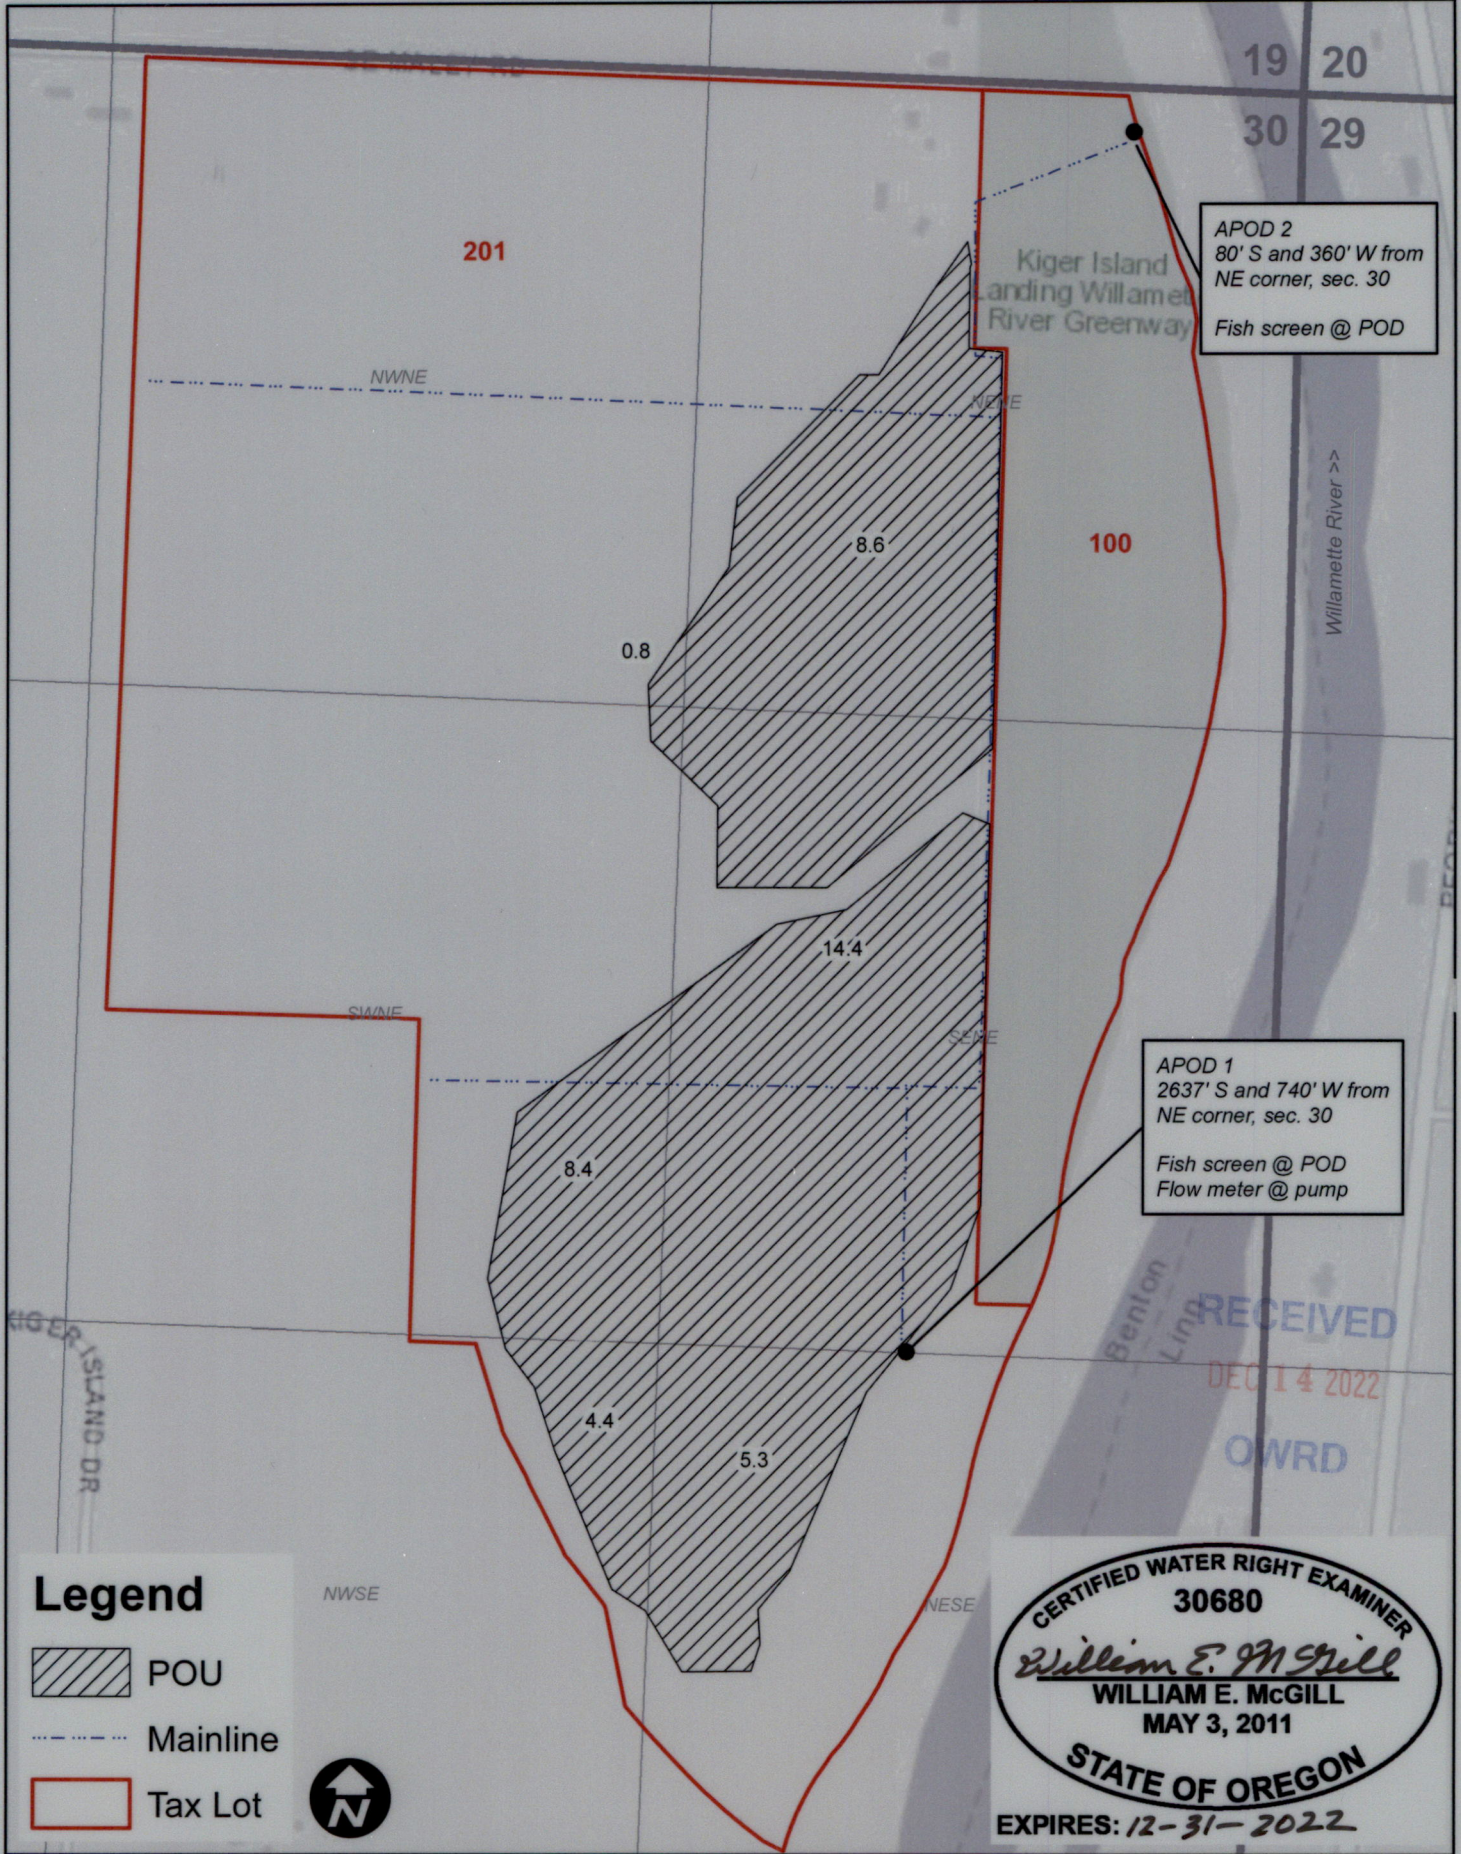

This map is not intended to provide legal dimensions or locations of property ownership lines.

WILL MCGILL SURVEYING LLC