SECTIONS 17 & 20, TWP.1 S. RANGE 10 E. W.M.
HOOD RIVER COUNTY, OREGON

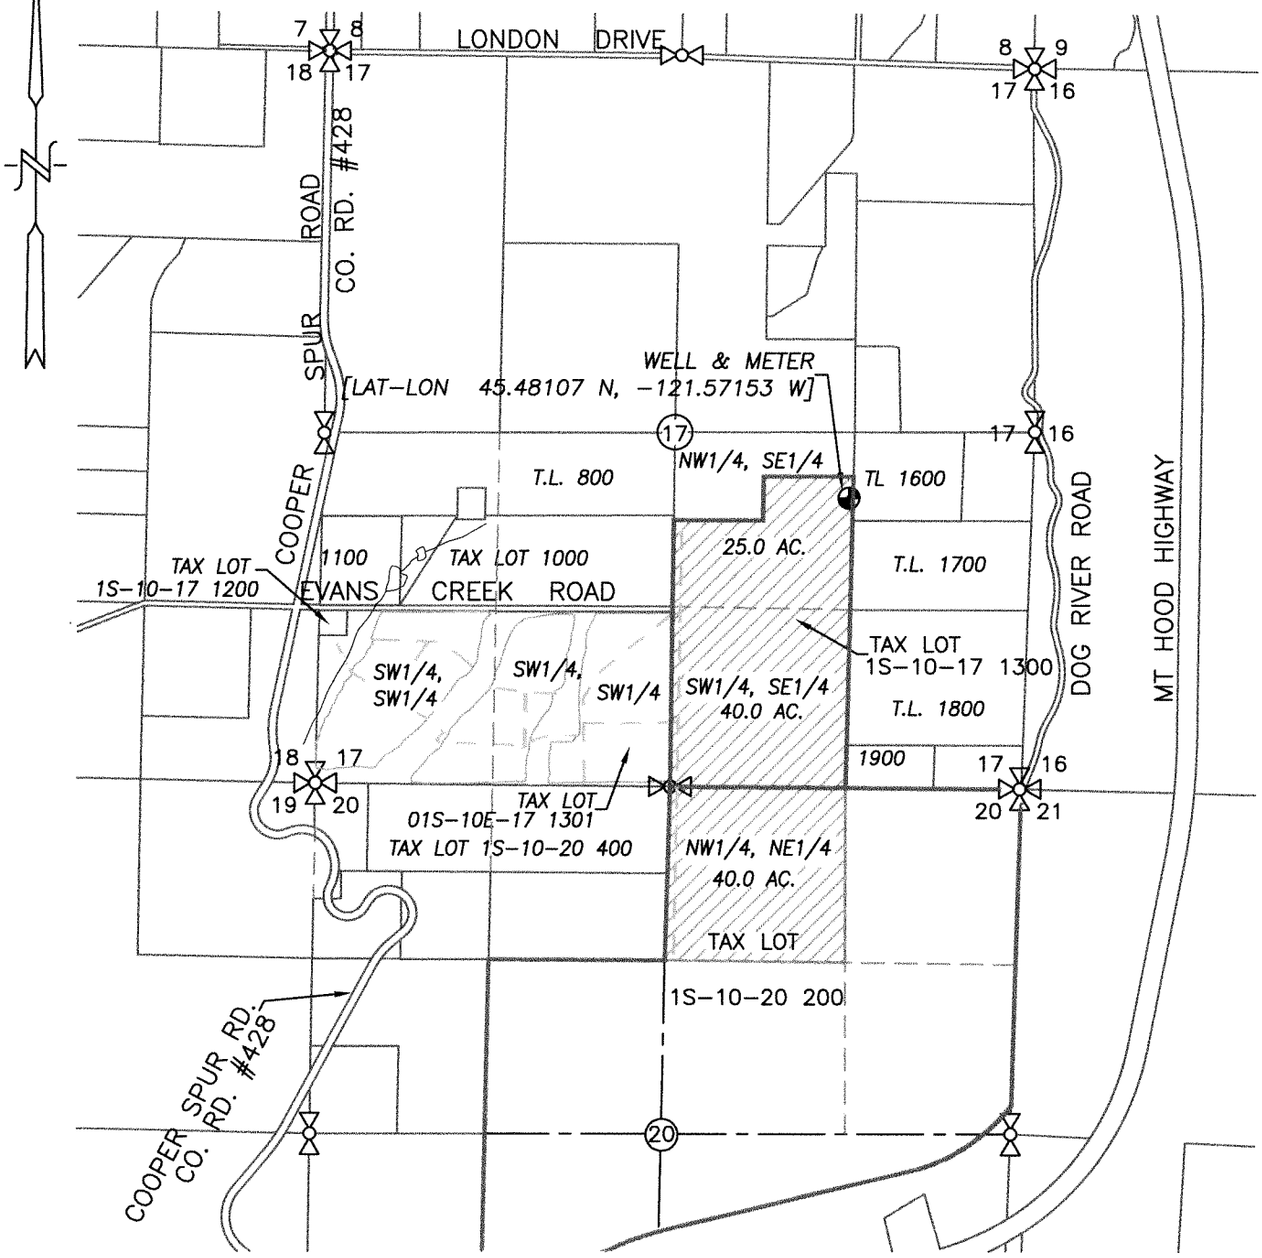

WELL: 499' S. & 1,379' W. OF THE E1/4 COR. SECTION 17

NEW IRRIGATION AREA = 105.0 ACRES

IRRIGATION MAIN

GROUND WATER APPLICATION MAP

SCALE: 1"= 1320'

0' 660' 1320' 2640'

APPLICATION No. G-18285

PERMIT No. _____

IN THE NAME OF:

HOOD RIVER CHERRY CO.

DATE: OCTOBER 13, 2016
REVISED WELL LOCATION 2/6/2023

BY: TENNESON ENGINEERING CORP.
3775 CRATES WAY
THE DALLES, OREGON. 97058
PH. 541-296-9177
FAX 541-296-6657

NOTE:
"THIS MAP IS NOT INTENDED TO PROVIDE LEGAL DIMENSIONS OR LOCATIONS OF PROPERTY OWNERSHIP LINES."

W.O. #14564wr