


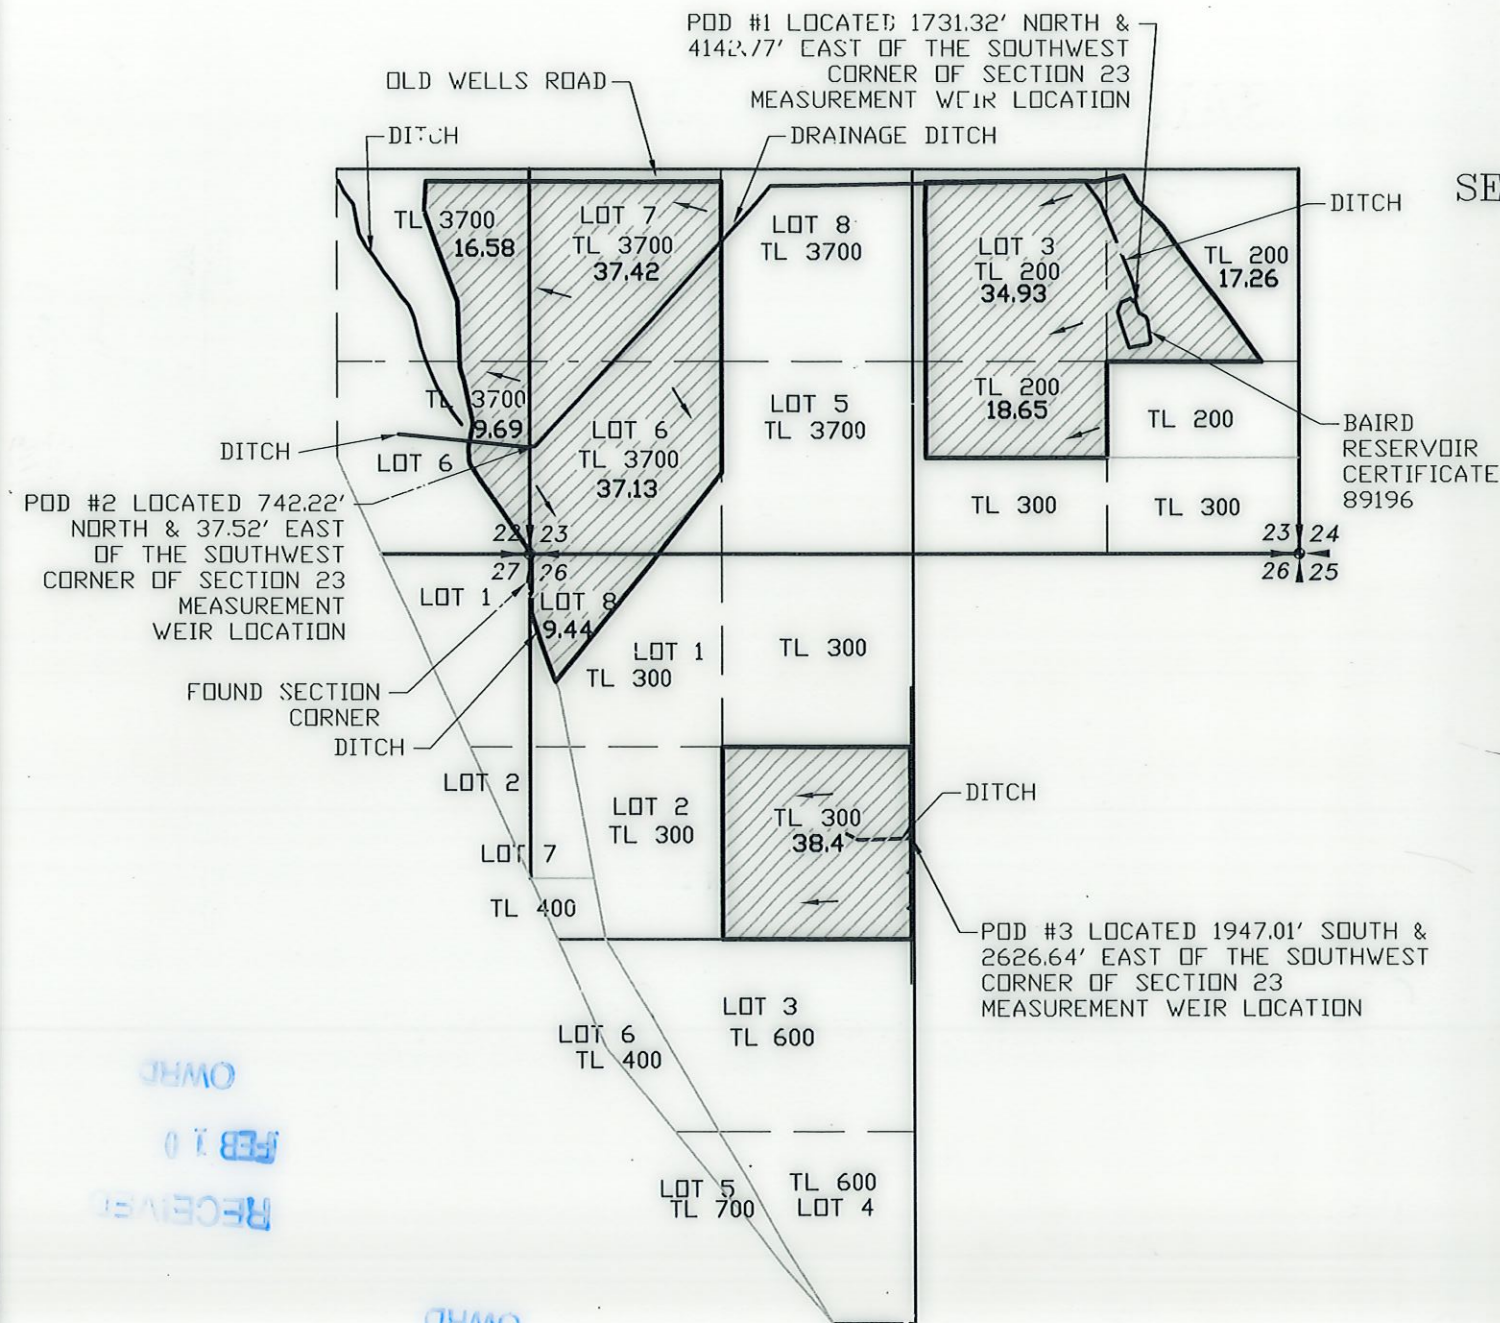

CLAIM OF BENEFICIAL USE MAP

FOR

SUSAN BERUTTI BAIRD

SECTION 22, 23 & 26, TOWNSHIP 40 SOUTH RANGE 20 EAST,
LAKE COUNTY, OREGON



RENEWAL 12/31/23

LEGEND

- SECTION LINE
- 1/4 SECTION LINE
- 1/16 SECTION LINE
- DITCH
- FLOOD FLOW DIRECTION
- ▨ IRRIGATED AREA - 219.50 ACRES



SCALE: 1"=1320'

APPLICATION NO. S-74424

PERMIT NO. S-53456

NOTE:
PREPARATION OF THIS MAP IS FOR IDENTIFYING PROPOSED
WATER RIGHTS ONLY. IT HAS NO INTENT TO PROVIDE
LOCATIONS OR DIMENSIONS OF PROPERTY BOUNDARIES.

REVISION	BY

ANDERSON ENGINEERING
AND SURVEYING, INC.
P.O. BOX 28
LAKEVIEW, OREGON 97630
(503) 947-4407
FAX: 947-2321

FOR:
SUSAN BERUTTI BAIRD
14472 HIGHWAY 395
LAKEVIEW, OR
97630

CLAIM OF BENEFICIAL USE
APPLICATION NO. S-74424
PERMIT NO. S-53456

DATE:	01/25/23
SCALE:	1"=1320'
DWG. BY:	R.C.
JOB:	2009-045
FILE:	2023
SHEET:	1 OF 1