


Claim of Beneficial Use - Transfer T-11426
 J. Bacon Farms, LLC






Township 5S, Range 5W, W.M.

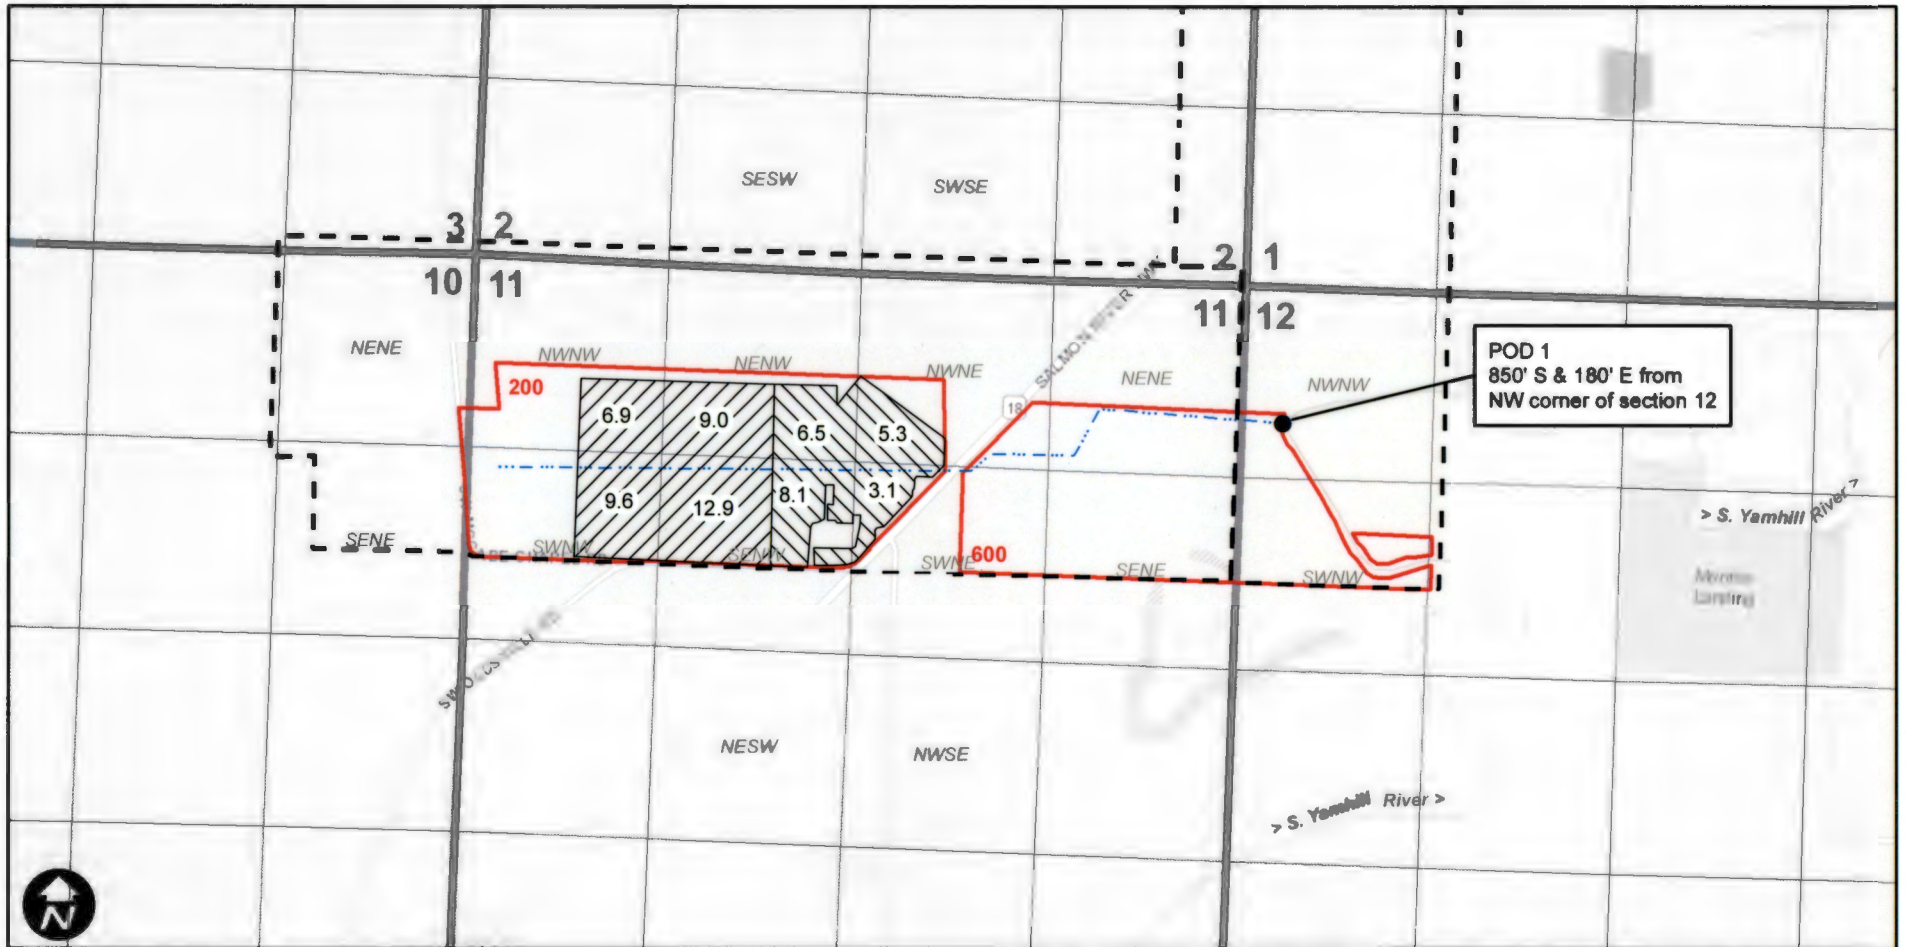

0 660 1,320 2,640 Feet

This map is not intended to provide legal dimensions or locations of property ownership lines.

Legend

-  Place of Use (from 40415)  DLC
-  Place of Use (from 45126)  Tax Lot
-  Mainline

RECEIVED

MAR 1 23

OWRD

CERTIFIED WATER RIGHT EXAMINER
 30680
William E. McGill
 WILLIAM E. MCGILL
 MAY 3, 2011
 STATE OF OREGON
 EXPIRES: 12-31-2024