


T 39 S, R 18 E

AK

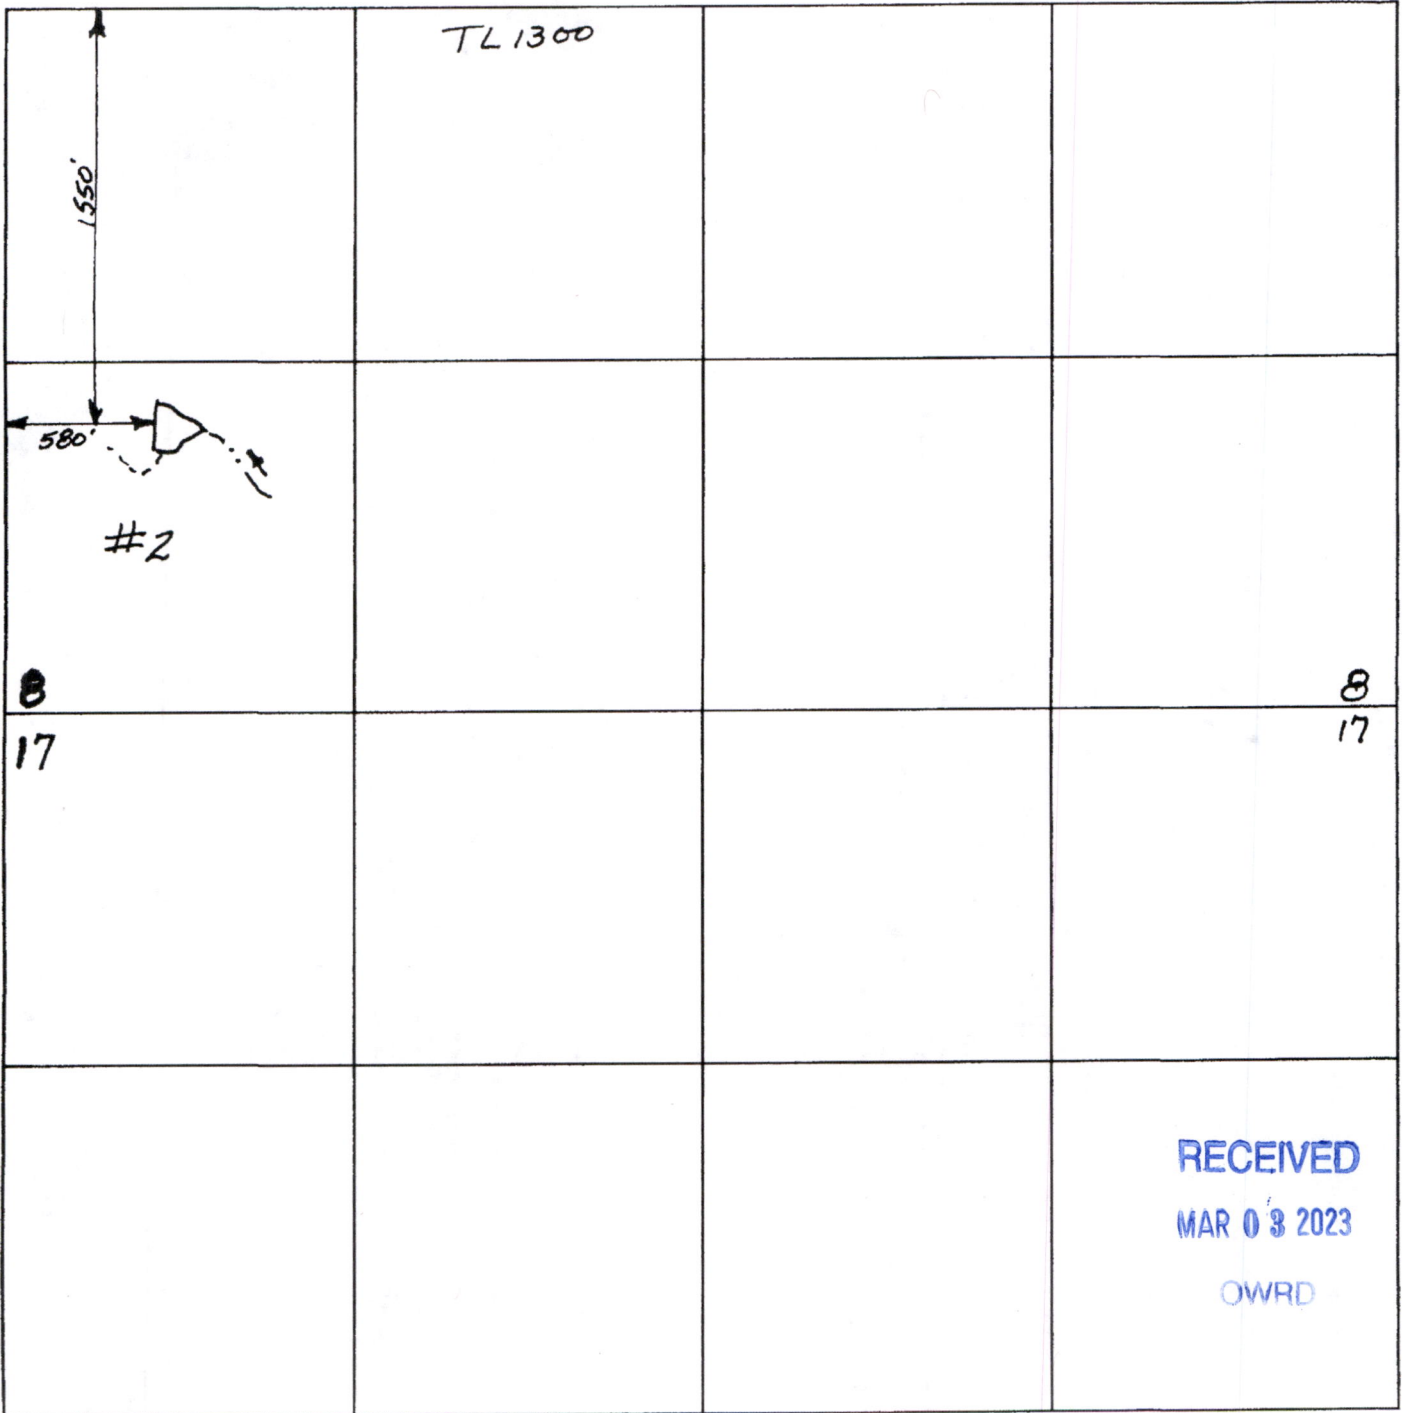

Scale 8" = 1 mile

app no R-85767
Permit No R-13906

RECEIVED
AUG 27 2003
WATER RESOURCES DEPT.
SALEM, OREGON