


T 39 S, R 17 E

13

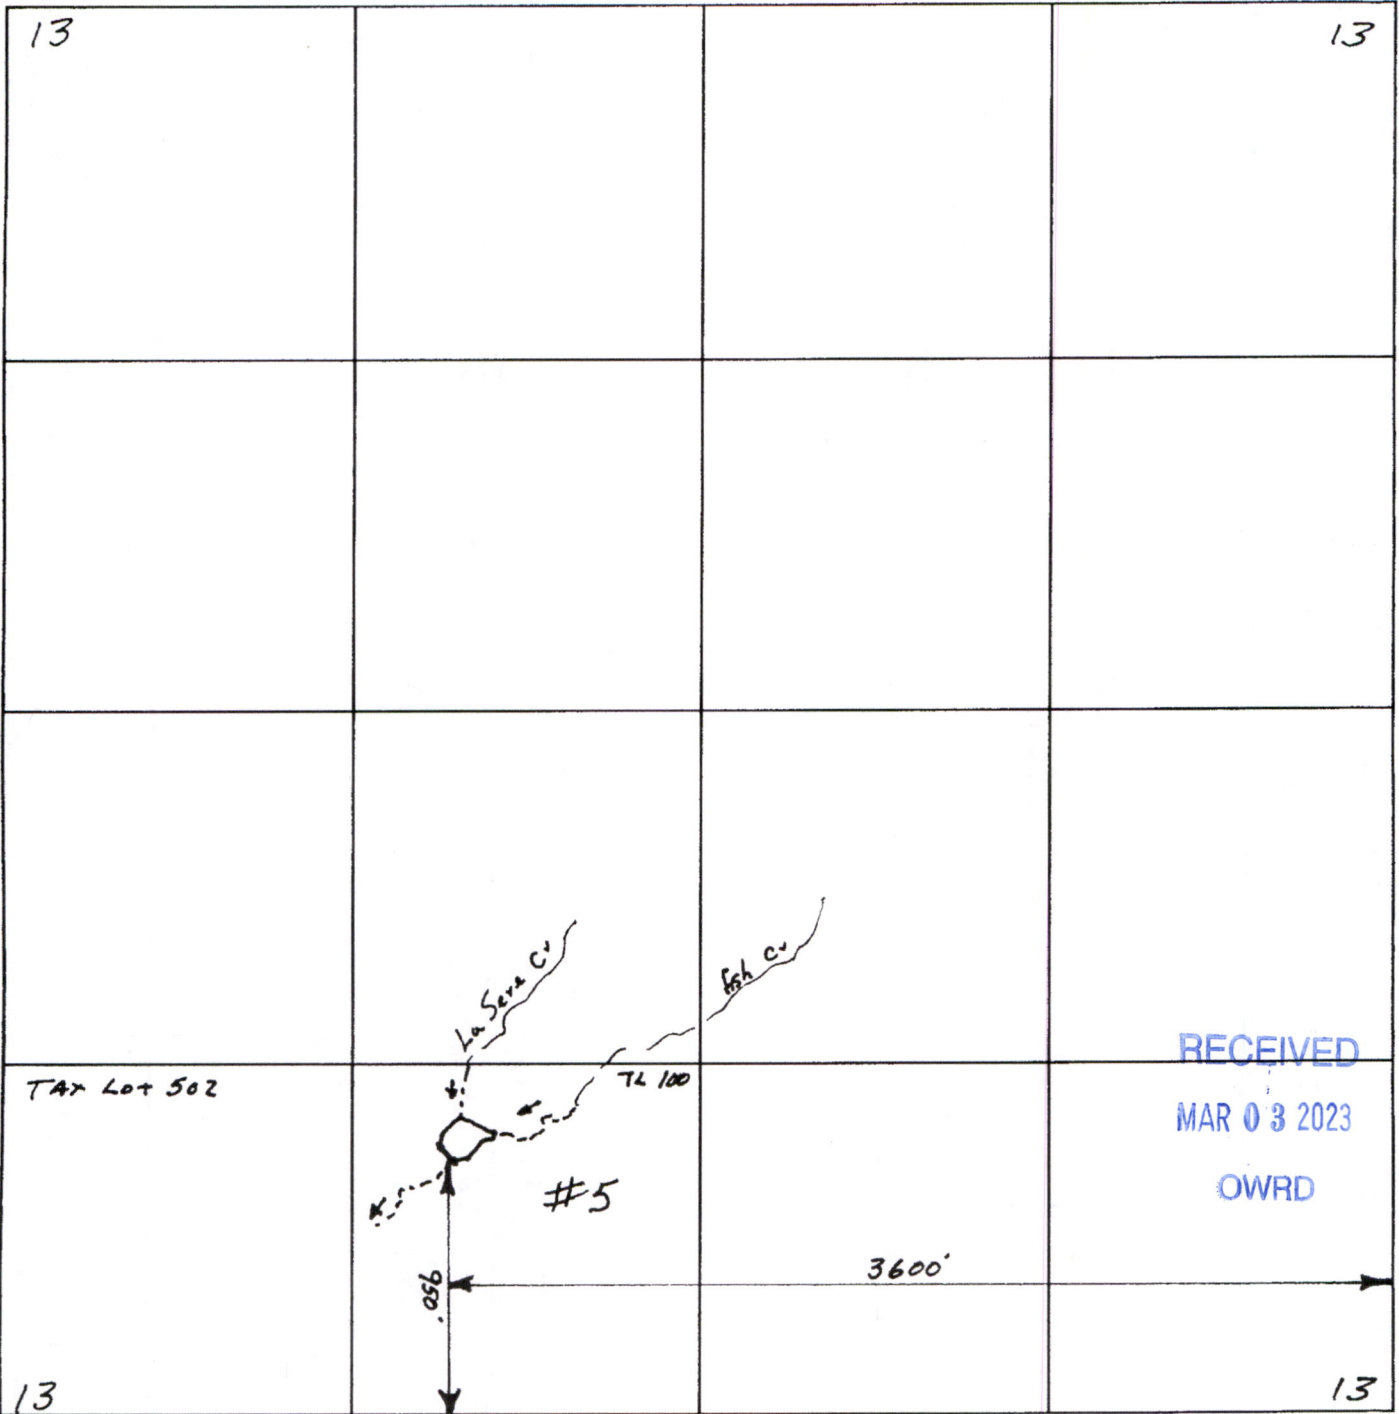

RECEIVED
MAR 03 2023
OWRD

Scale 8" = 1 mile

app no R-88765
Permit NO R 13904

RECEIVED
AUG 27 2003
WATER RESOURCES DEPT.
SALEM, OREGON