


T 39 S, R 18 E

AN
h

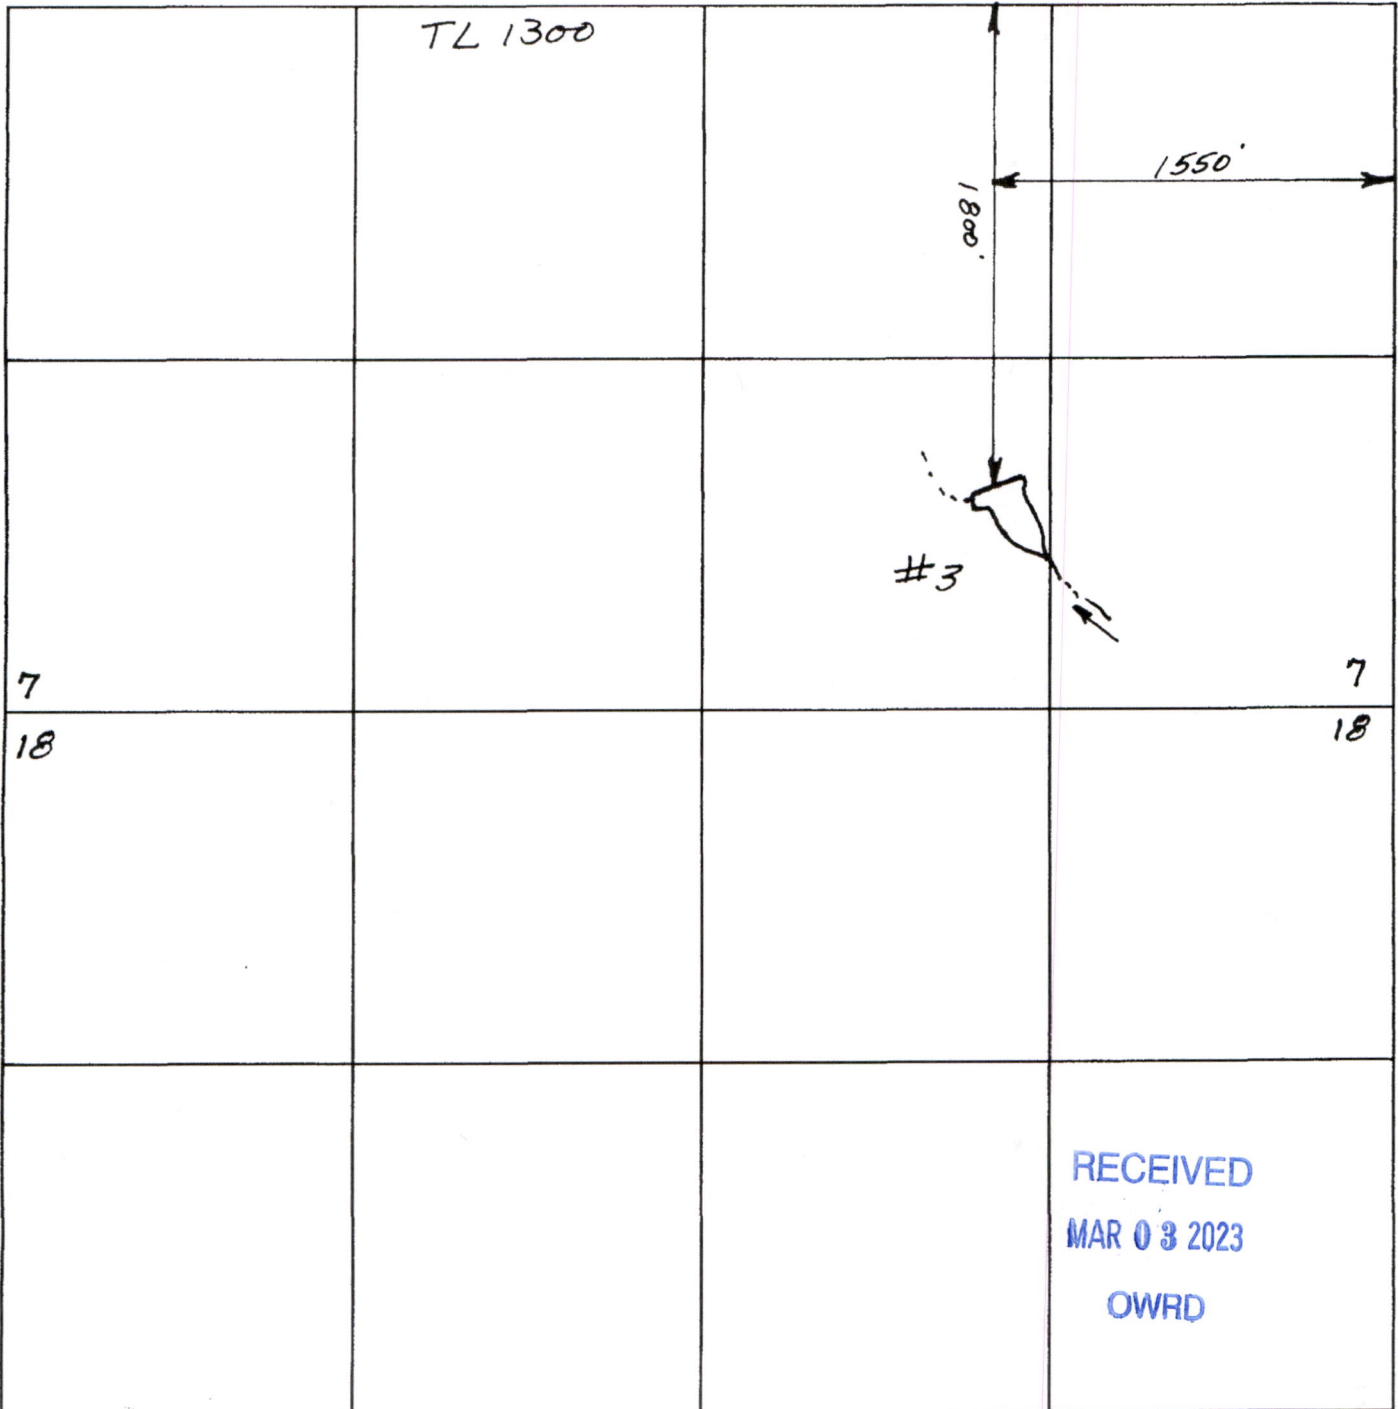

Scale 8" = 1 mile

app no R-85763
Permit No R-13902

RECEIVED
AUG 27 2003
WATER RESOURCES DEPT.
SALEM, OREGON