

# FINAL PROOF SURVEY



UNDER

APPLICATION # R-70144 & 70145 PERMITS R11234 & 51023  
APPLICATION # R-70859 PERMIT R11350

IN THE NAME OF

**JAMES R. STEWART**  
HC 60 BOX 1800  
LAKEVIEW, OREGON 97630

SURVEYED NOVEMBER 24, 1993

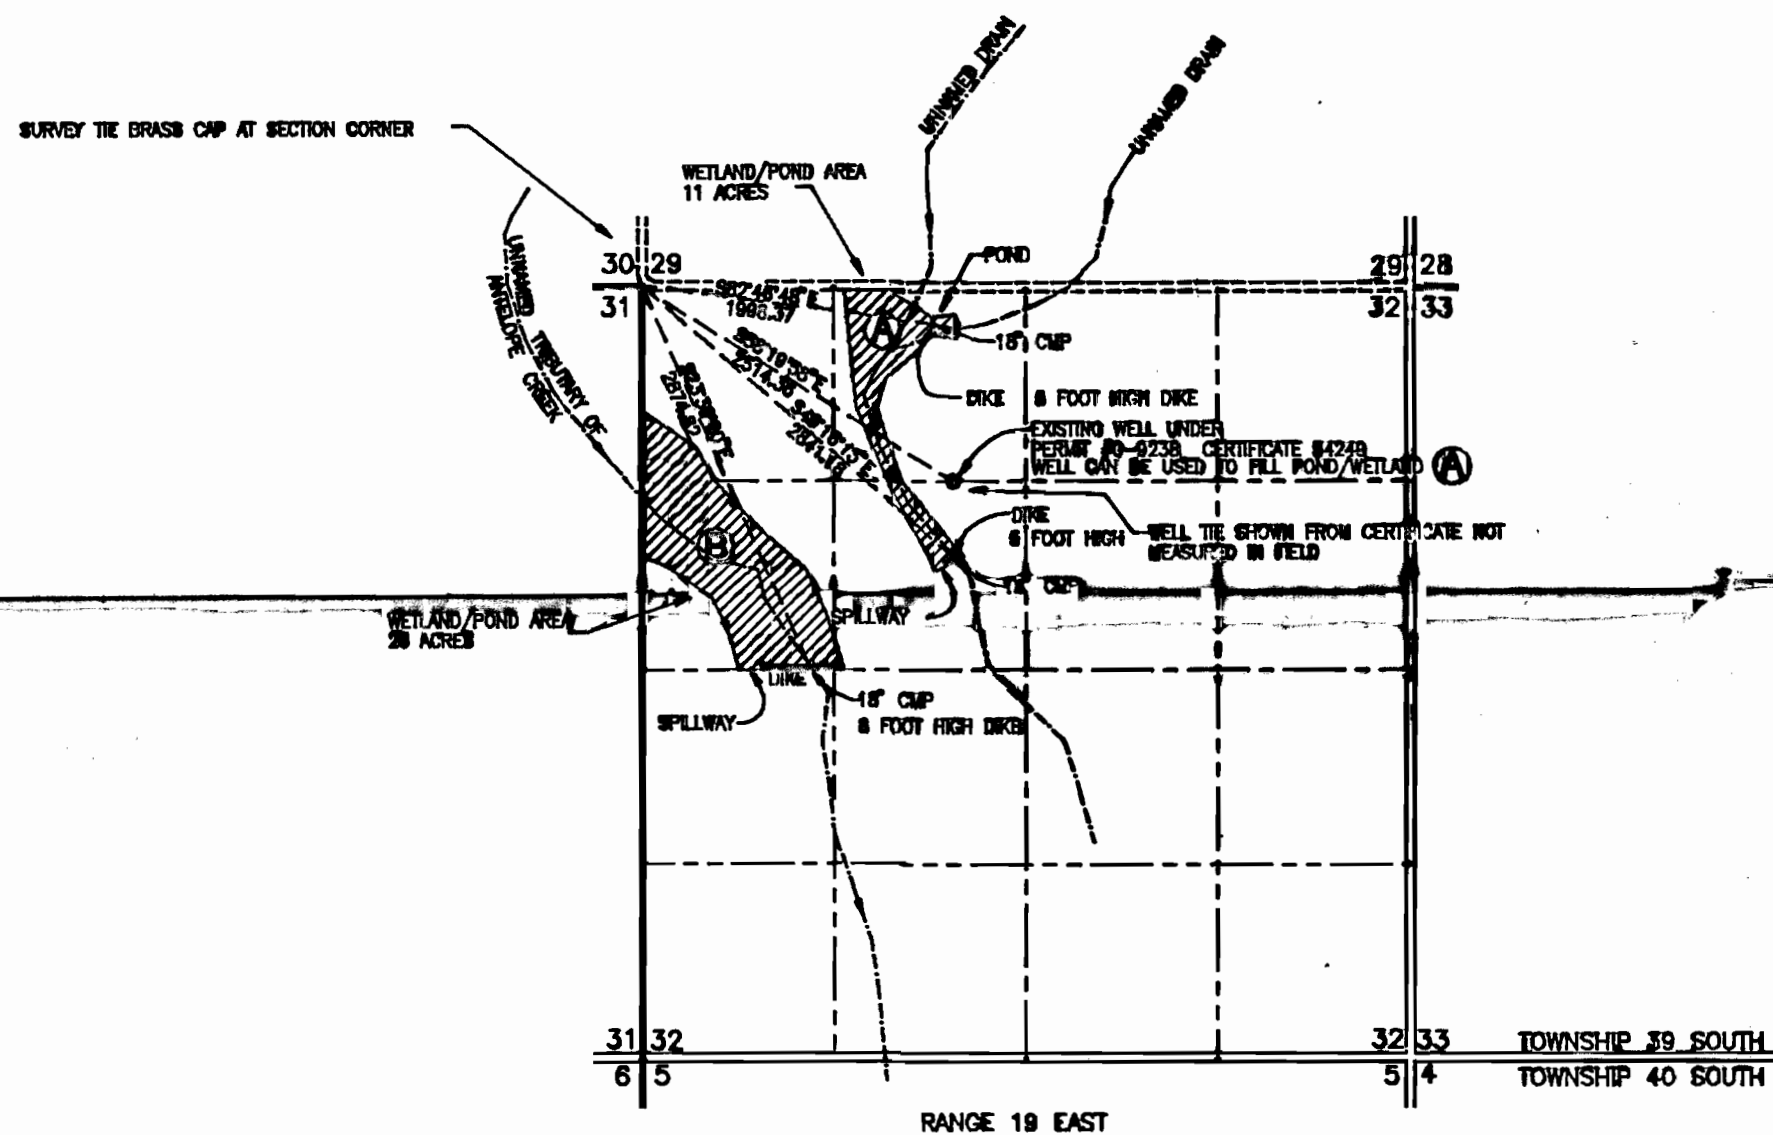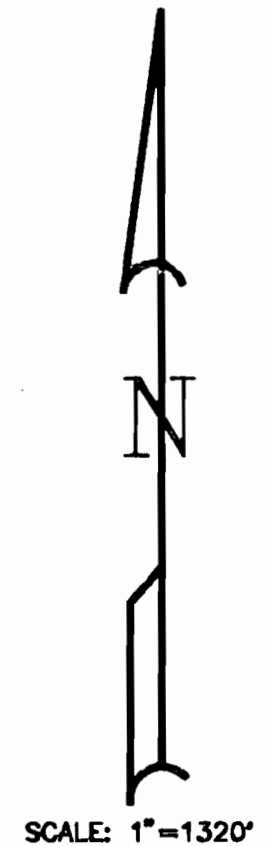

## LEGEND

- SECTION LINE
- - - 1/4 SECTION LINE
- - - 1/16 SECTION LINE
- ▨ RESERVOIR/WETLAND AREAS
- ==== PAVED COUNTY ROAD
- UNIMPROVED COUNTY ROAD
- ~~~~~ DRAINAGE/TRIBUTARY
- - - SURVEY TIE LINE
- Ⓐ RESERVOIR/WETLANDS CREATED UNDER APPLICATION # R-70859  
MAX. CAPACITY = 5.00 AC-FT.
- Ⓑ RESERVOIR/WETLANDS CREATED UNDER APPLICATION # R-70144  
MAX. CAPACITY = 39.45 AC-FT.


### SITE REPORT

THIS DEVELOPMENT CONSTRUCTED PONDS AND WETLAND AREAS FOR WILDLIFE AND STOCKWATER USE. THE LARGE DAM/DIKE WAS CONSTRUCTED AS PER PLANS APPROVED BY THE DEPARTMENT DAM SAFETY SECTION ON JULY 24, 1990. THE RESERVOIR AREAS AS SHOWN IMPOUND WATER OR CREATE A WETLAND OVER THE AREAS SHOWN FOR WILDLIFE HABITAT. BOTH AREAS HAD SOME WATER IN THEM AT THE TIME OF OUR INSPECTION. HOWEVER IT WAS EVIDENT THAT LAST SPRING THE PONDS WERE FULL AND THAT WATER EXITED THROUGH THE SPILLWAY OR OVERFLOW PIPES.

NOTE: PREPARATION OF THIS MAP IS FOR IDENTIFYING PROPOSED WATER RIGHTS ONLY. IT HAS NO INTENT TO PROVIDE LOCATIONS OR DIMENSIONS OF PROPERTY BOUNDARIES..

THE FINAL PROOF SURVEY AND INSPECTION OF THE USE AS FOUND TO BE COMPLETED UNDER THE TERMS AND CONDITIONS OF PERMITS R11234, R11350, AND 51023 WAS COMPLETED BY ME ON NOVEMBER 24, 1993 AND THE FACTS CONTAINED IN THIS REPORT AND ABOVE FINAL PROOF MAP ARE CORRECT TO THE BEST OF MY KNOWLEDGE.

*Darryl Anderson*  
DARRYL ANDERSON  
CERTIFIED WATER RIGHTS EXAMINER  
Exp. 12/31/93

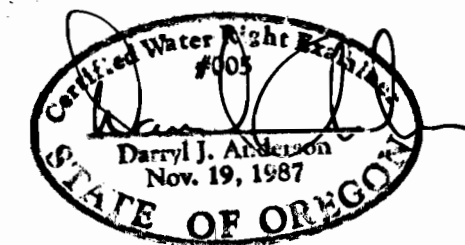

### PREPARED FOR:

JAMES R. STEWART  
HC 60 BOX 1800  
LAKEVIEW, OREGON 97630

### PREPARED BY:

ANDERSON ENGINEERING AND SURVEYING  
P.O. BOX 28  
LAKEVIEW, OREGON 97630  
(503) 947-4407 FAX 947-2321

I, JAMES R. STEWART, AGREE TO THE FINDINGS OF THE WATER RIGHTS EXAMINER AND DO SUBMIT THIS SITE REPORT AND MAP AS MY CLAIM OF BENEFICIAL USE OF THE WATER AS PROVIDED UNDER THE TERMS AND CONDITIONS OF PERMITS R11234, R11350, AND 51023.

*James R. Stewart*  
JAMES R. STEWART

DATE: 12-17-93

DECEMBER 13, 1993  
JOB NO: 93092

SHEET 1 OF 1  
CAD FILE: STEWART.DWG