

Laura A. Schroeder
Oregon, Idaho,
Nevada, Washington & Utah

Therese A. Ure
Oregon & Nevada

Sarah R. Liljefelt
Oregon,
California & Utah

William F. Schroeder
(1928 - 2015)



SCHROEDER
LAW OFFICES, P.C.

Jakob S. Wiley
Oregon

Wyatt E. Rolfe
Of Counsel
Oregon & Washington

James Browitt
Of Counsel
Idaho & Washington

July 3, 2019

VIA US MAIL

Oregon Water Resources Department
725 Summer Street NE, Suite A
Salem, OR 97301

RE: Certificate 30463 Ownership Update

To Whom It May Concern:

Enclosed on behalf of Layne and Janelle Jackson, please find an ownership update for Certificate 30463.

Thank you for your assistance with this matter.

Very truly yours,
SCHROEDER LAW OFFICES, P.C.


Tara J. Jackson
Paralegal

TJJ:srl

Enclosure

cc: Client

RECEIVED
JUL 08 2019
OWRD

1915 NE Cesar E. Chavez Boulevard, Portland, Oregon 97212 (503) 281-4100

10615 Double R Boulevard, Suite 100, Reno, Nevada 89521 (775) 786-8800

www.water-law.com counsel@water-law.com



Oregon Water Resources Department
725 Summer Street NE, Suite A
Salem, Oregon 97301
(503) 986-0900
www.wrd.state.or.us

Ownership Update For Certificated Rights Only

NO FEES ARE REQUIRED TO SUBMIT THIS FORM

NOTICE: A certificate of water right typically stays with the land. In order to track water right ownership, the Department requests that this form be submitted to the Department. **To update multiple rights, a separate form is required for each right.**

If you have any questions about this form, please contact your local watermaster, or call the Water Resources Department at (503) 986-0900.

This form is not for Applications, Permits, Transfers, Groundwater Registrations, or Limited Licenses. To notify the Department of changes in ownership to these types of authorizations, an Assignment is required.

Current Landowner Information

Name: Layne Willard and Janelle Jackson

Mailing Address: 55973 Scotty Creek Ln.

City: Seneca State: OR Zip: 97873

Phone (Work): 978-901-7216

Property Description

County: Grant Township: 16 S Range: 30 E Section: 16

Taxlot Number(s): 1500

Street Address of water right property: N/A

Water Right Information: Application: S- 29177 Permit: S- 22990 Certificate #: 30463

Are all the lands associated with this water right owned by the requester? Yes ___ No X If No, include a map showing the portion of the right involved.


Name of individual completing this form: Layne Willard Jackson Phone: 978-901-7216

Signature of requester: Layne Willard Jackson Date: 06 May 2019

The Department does not change names on certificates. This form will be placed in the file for future reference only. The Department does not provide acknowledgement that this form has been received.

T.16S.R.30E.W.M.

Tax Lot 1500

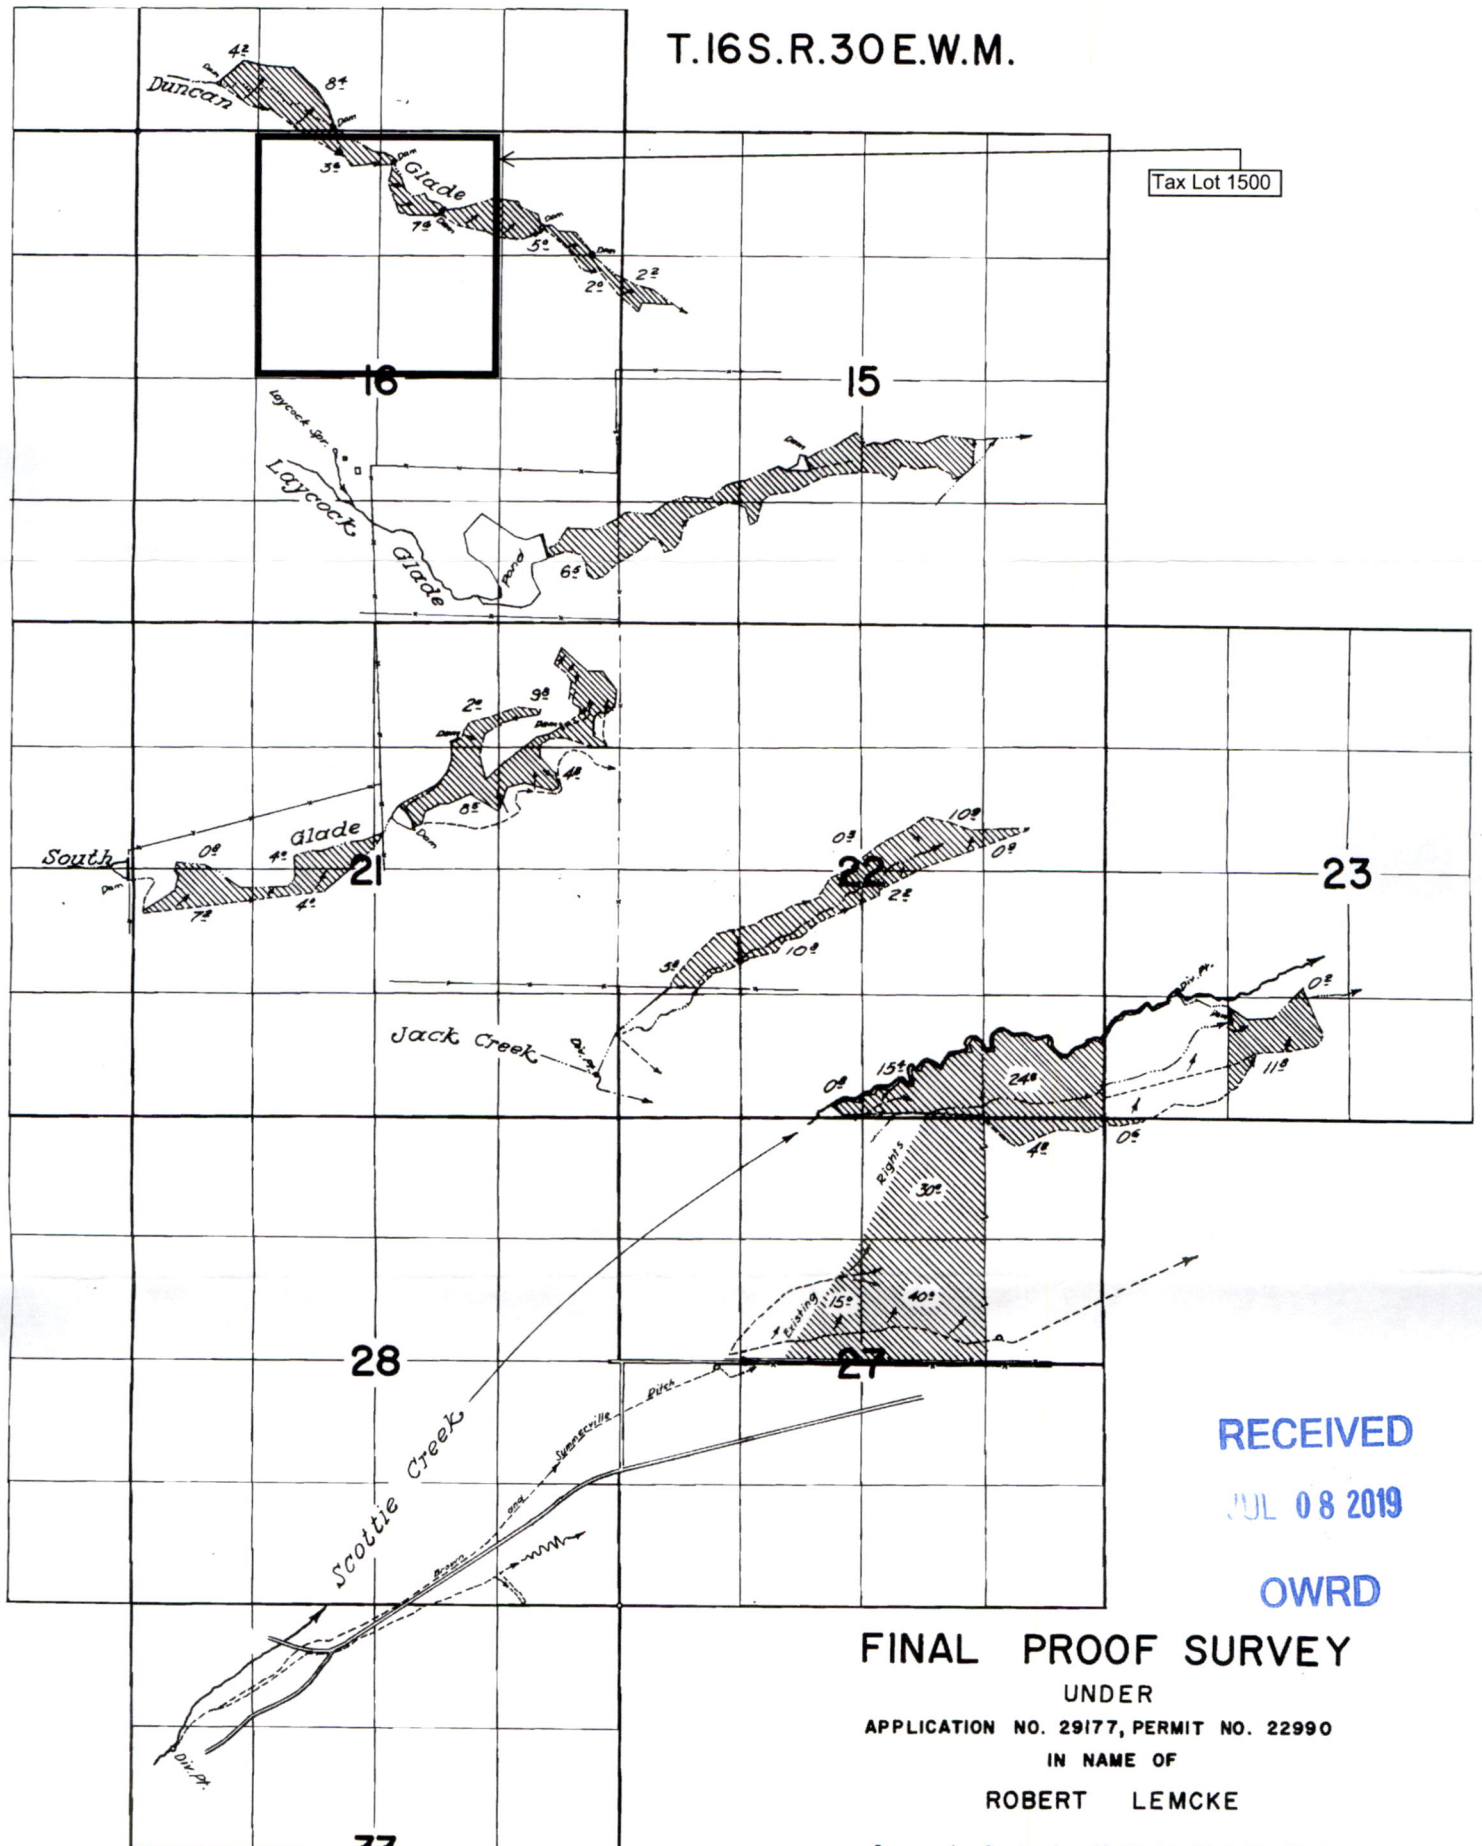

RECEIVED

JUL 08 2019

OWRD

FINAL PROOF SURVEY

UNDER

APPLICATION NO. 29177, PERMIT NO. 22990

IN NAME OF

ROBERT LEMCKE

Surveyed September 12, 13, 14, 15 & 19, 1961

by

[Signature]