



PERMIT S-55347 CLAIM OF BENEFICIAL USE (10 AC SUPPL. IRRIG. ON TAX LOT 1000 FROM GALESVILLE RESERVOIR)

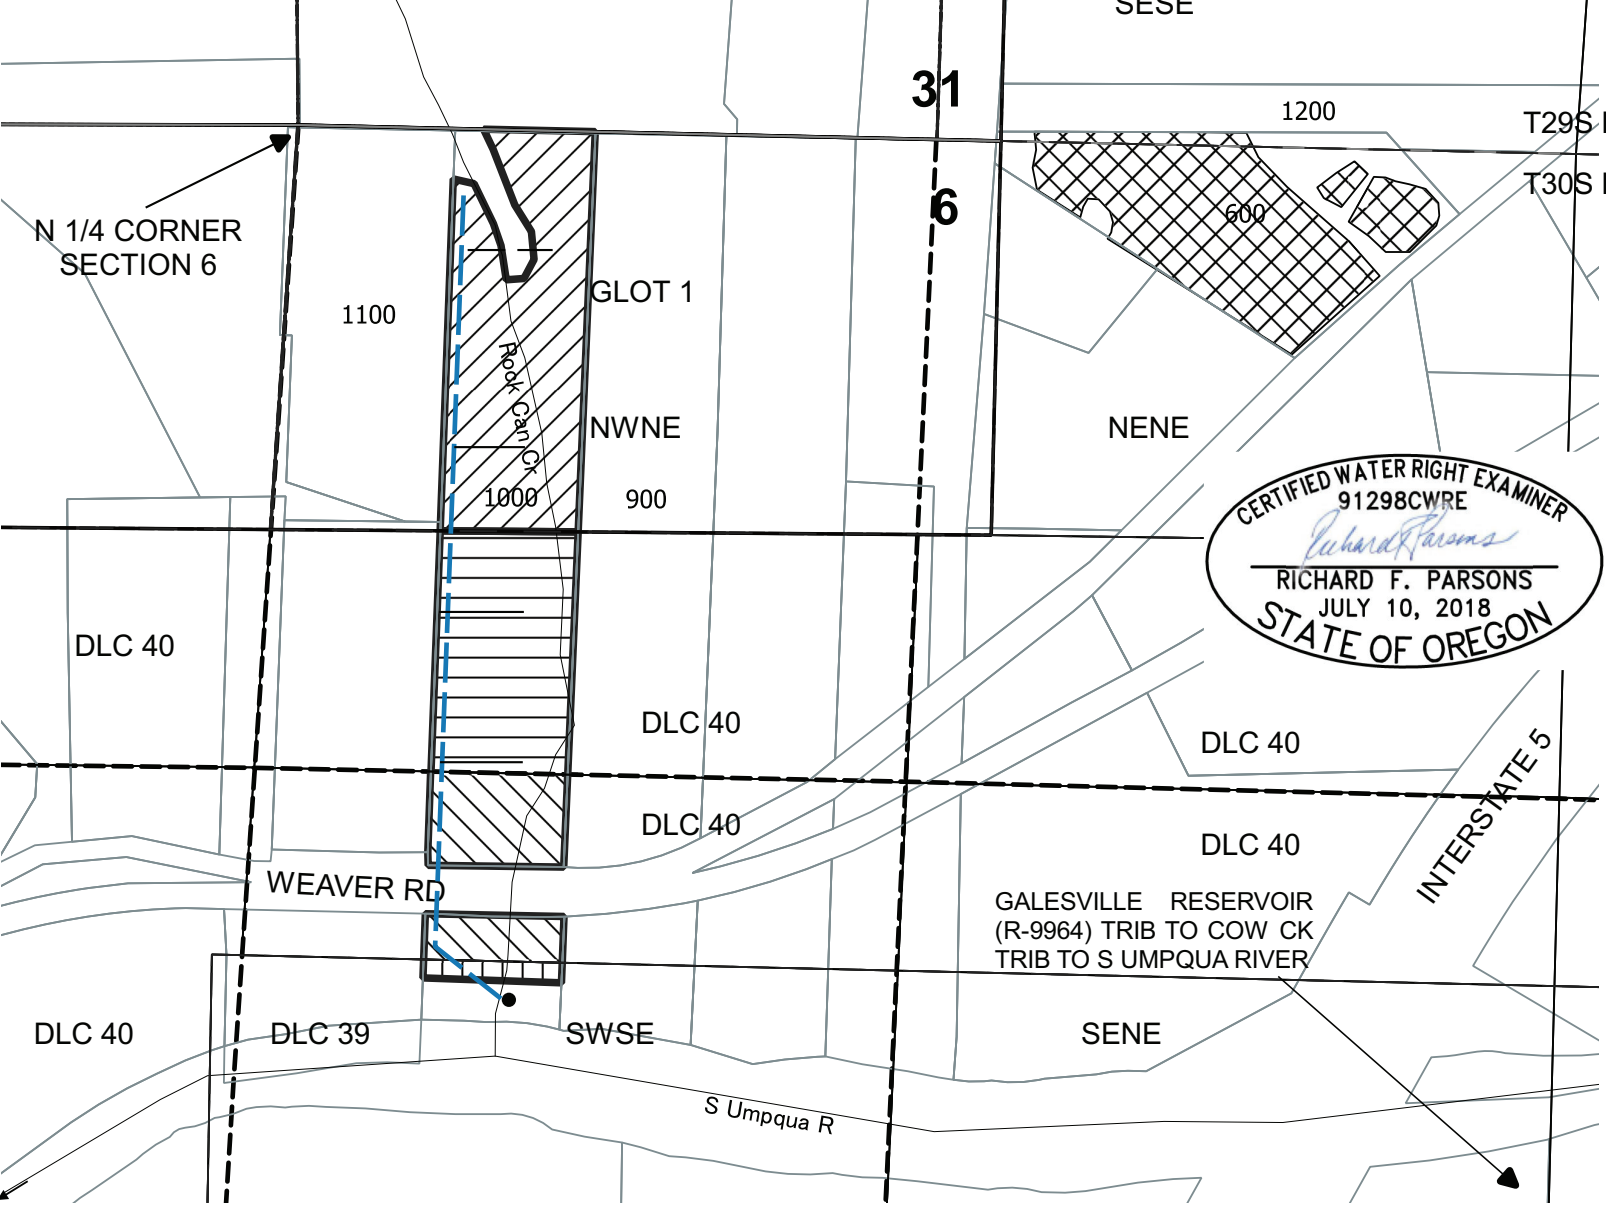


CERTIFIED WATER RIGHT EXAMINER
91298CWRE
Richard Parsons
RICHARD F. PARSONS
JULY 10, 2018
STATE OF OREGON

NW NE SEC 6 7.8 ACS
GLOT 1 - 4.5 ACS

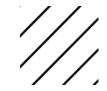


DLC 40 - 3.3 ACS

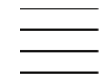

SW NE SEC 6 2.2 ACS
DLC 40 - 1.93 ACS



DLC 39 - 0.27 ACS

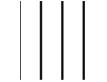

C-54152 PRIMARY
ROCK CANYON CK 4.5 ACS
ROCK CANYON CK/S UMPQUA
4.6 ACS
S UMPQUA
0.9 ACS



● POD #1
1810' S 565' E
N 1/4 CORNER
SECTION 6

--- PIPELINE

S-55347 POU NOT
INCLUDED IN
THIS COBU



This map is not intended to provide legal dimensions or locations of property ownership lines

Quarter Quarter boundaries in Section 6 estimated based on BLM Cadastral survey points

ParsonsWater Consulting LLC
rick.parsons@parsonwater.com
541.499.0257 303.667.5067

1" = 400 feet

