


# T. 2 S., R. 6 E., W.M.

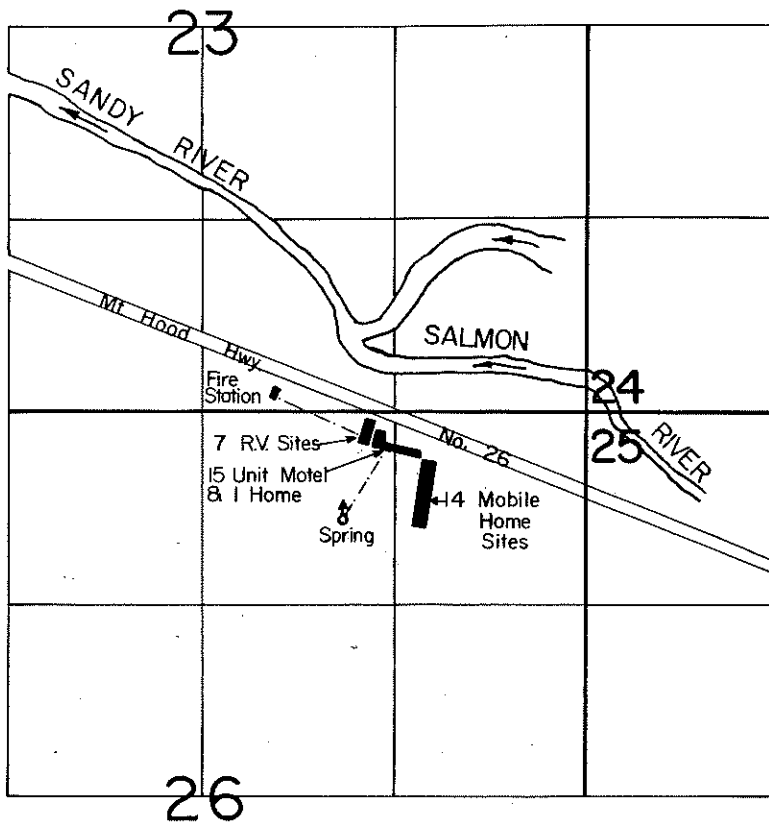

Spring Loc.: 750' S. & 960' E. from N. 1/4 Cor. Sec. 26.

Scale: 1" = 1320'

## FINAL PROOF SURVEY UNDER

Application No. 61929 Permit No. 47404

IN NAME OF

DELOYD KERTON COOK

Surveyed Nov. 1 1989, by T. Warren

7307  
7308

0109