



Claim of Beneficial Use - ACMPC Oregon 3, LLC Application S-88398, Permit S-55124

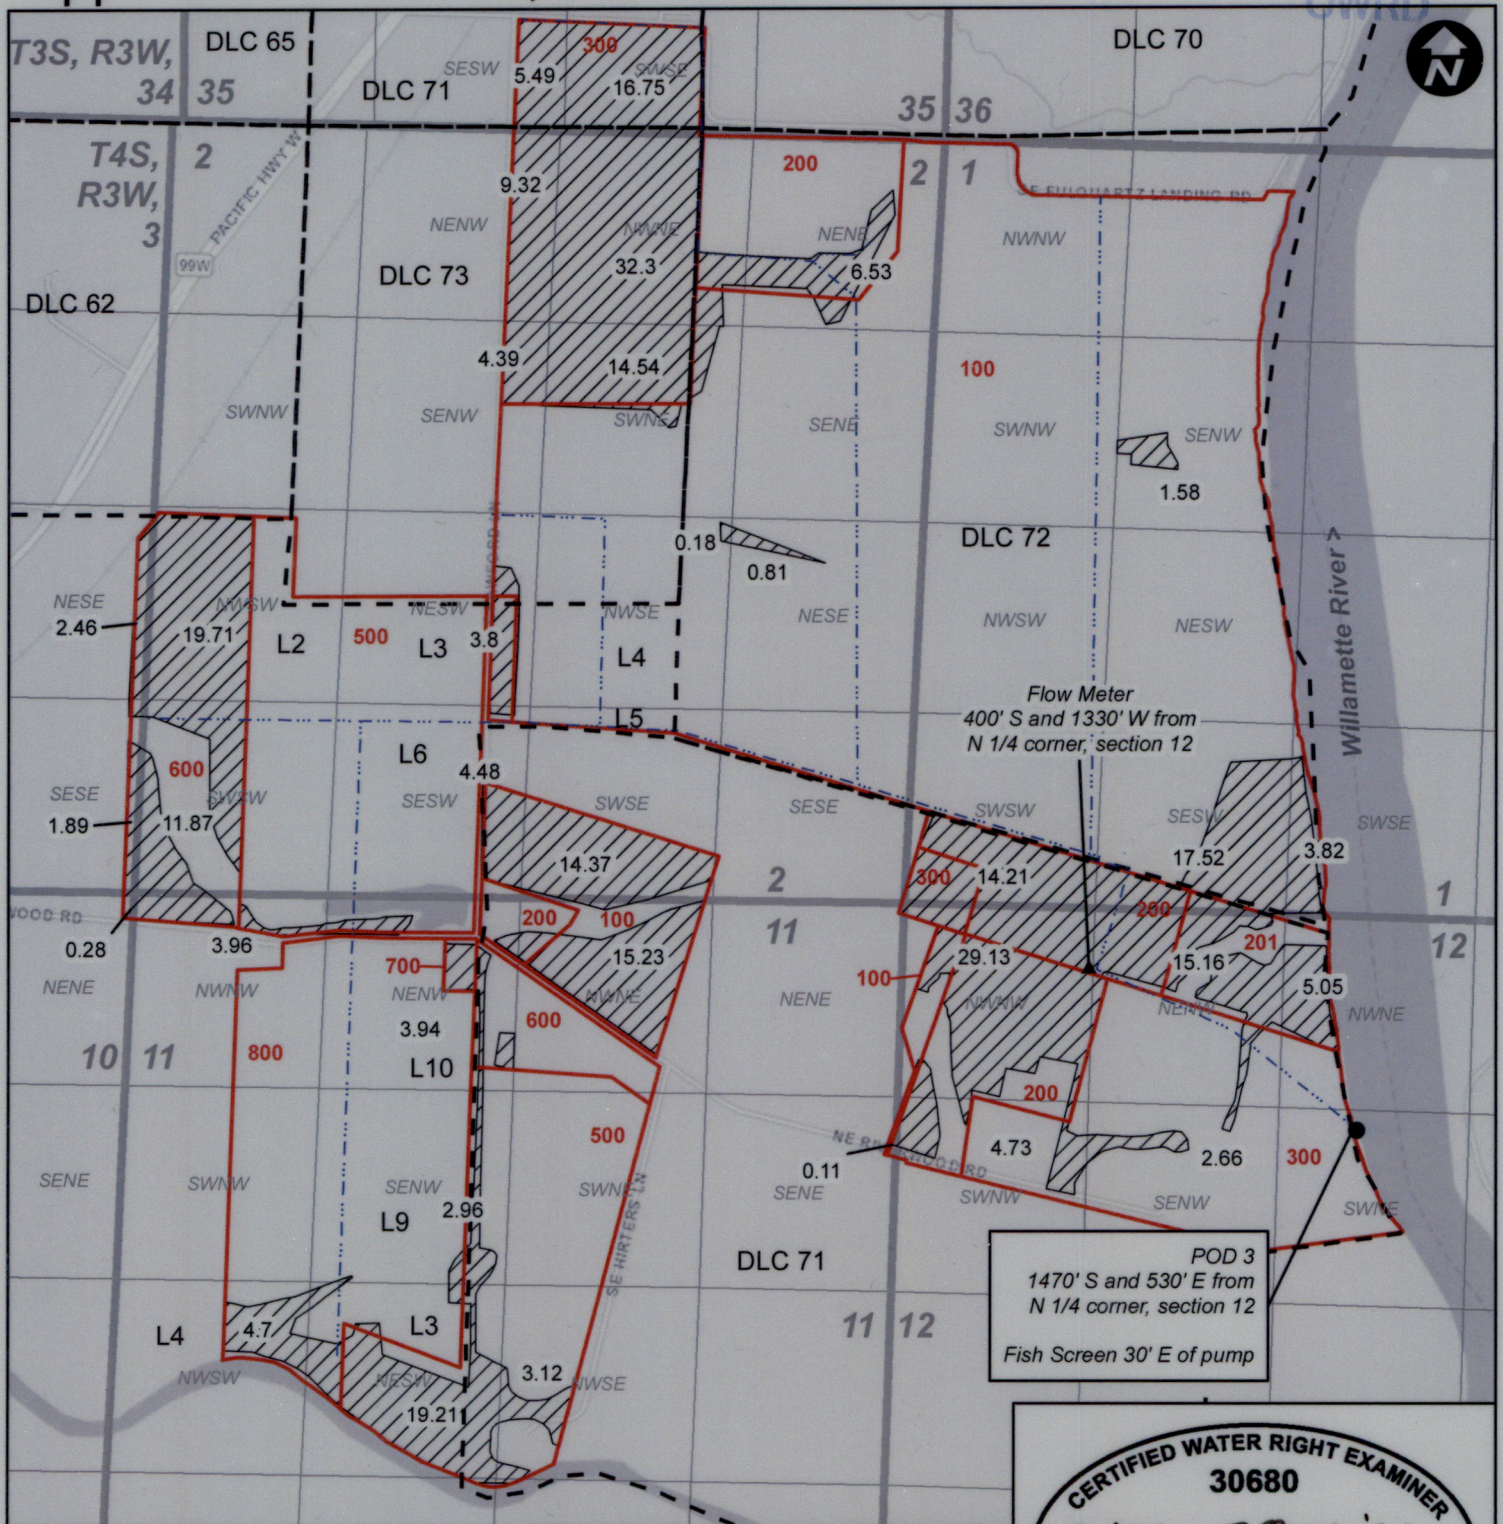

Legend

- POU
- Taxlots
- Mainline
- DLC

This map is not intended to provide legal dimensions or locations of property ownership lines.

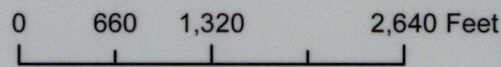

POD 3
1470' S and 530' E from
N 1/4 corner, section 12
Fish Screen 30' E of pump

CERTIFIED WATER RIGHT EXAMINER
30680
William E. McGill
WILLIAM E. MCGILL
MAY 3, 2011
STATE OF OREGON
EXPIRES: 12-31-2024