


FINAL PROOF SURVEY
CLAIM OF BENEFICIAL USE
PERMITS No. 52920 & No. R-12076
IN THE N $\frac{1}{2}$ NE $\frac{1}{4}$ SEC. 28 & SW $\frac{1}{4}$ SE $\frac{1}{4}$ SEC. 21
T6N, R2W, COLUMBIA COUNTY, OREGON

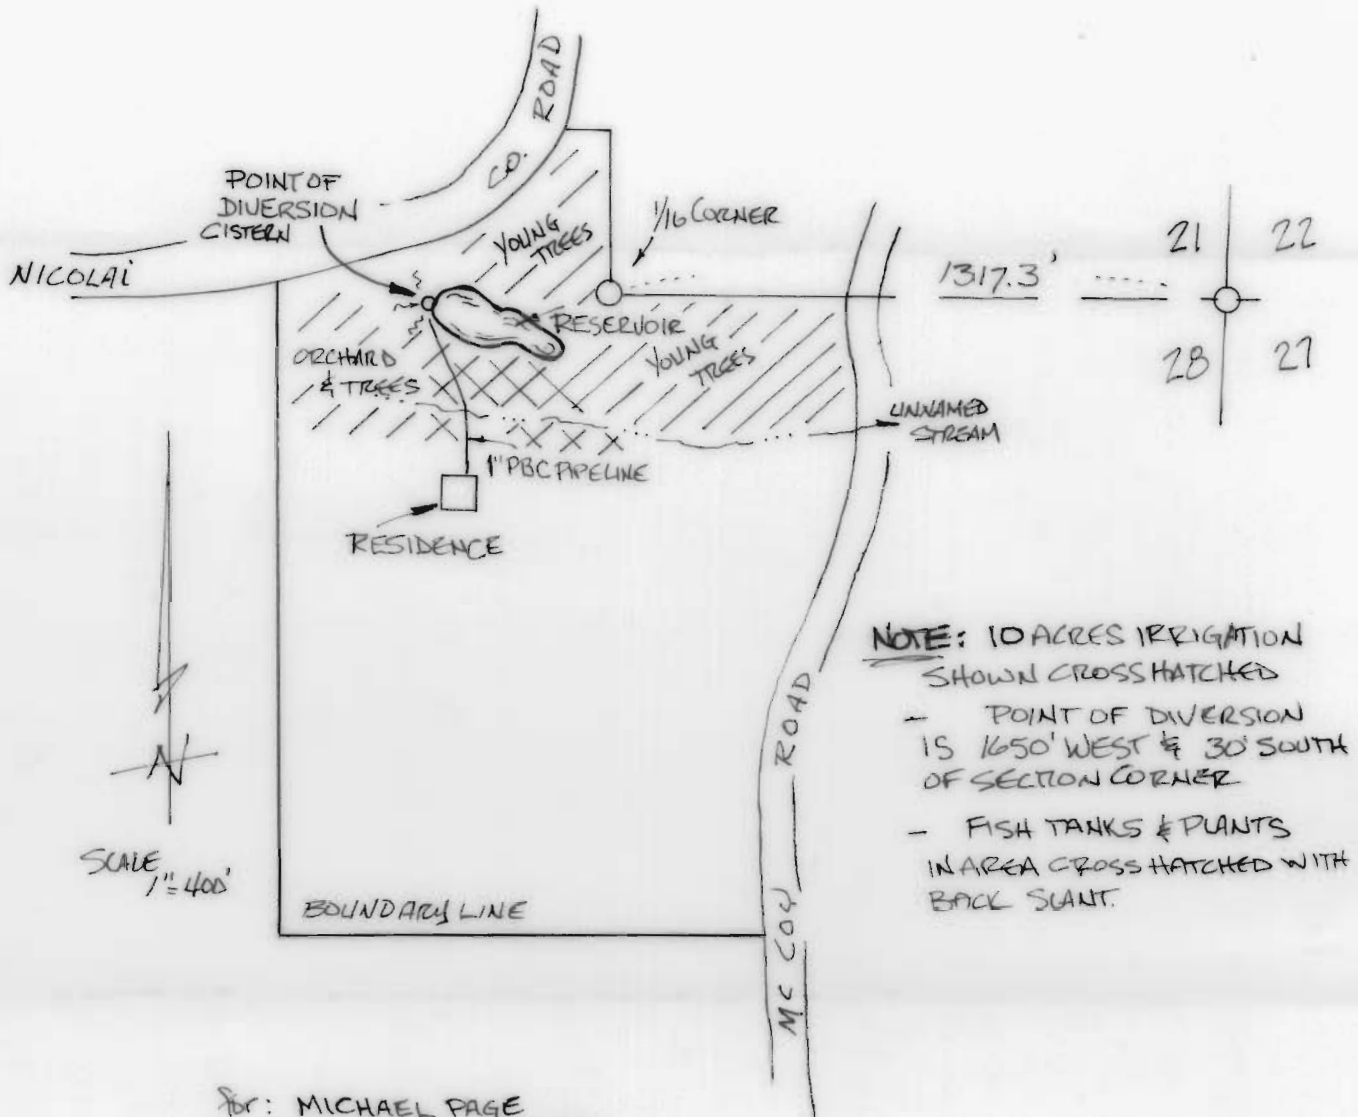

for: MICHAEL PAGE
68044 NICOLAI RD.
RAINIER, OREGON 97048

by: LESLIE KEENON
1224 ALDER ST.
VERNONIA, OREGON 97064



RECEIVED

OCT 07 2003

WATER RESOURCES DEPT.
SALEM, OREGON