


T.5S. R.1E. Section 5, W.M.

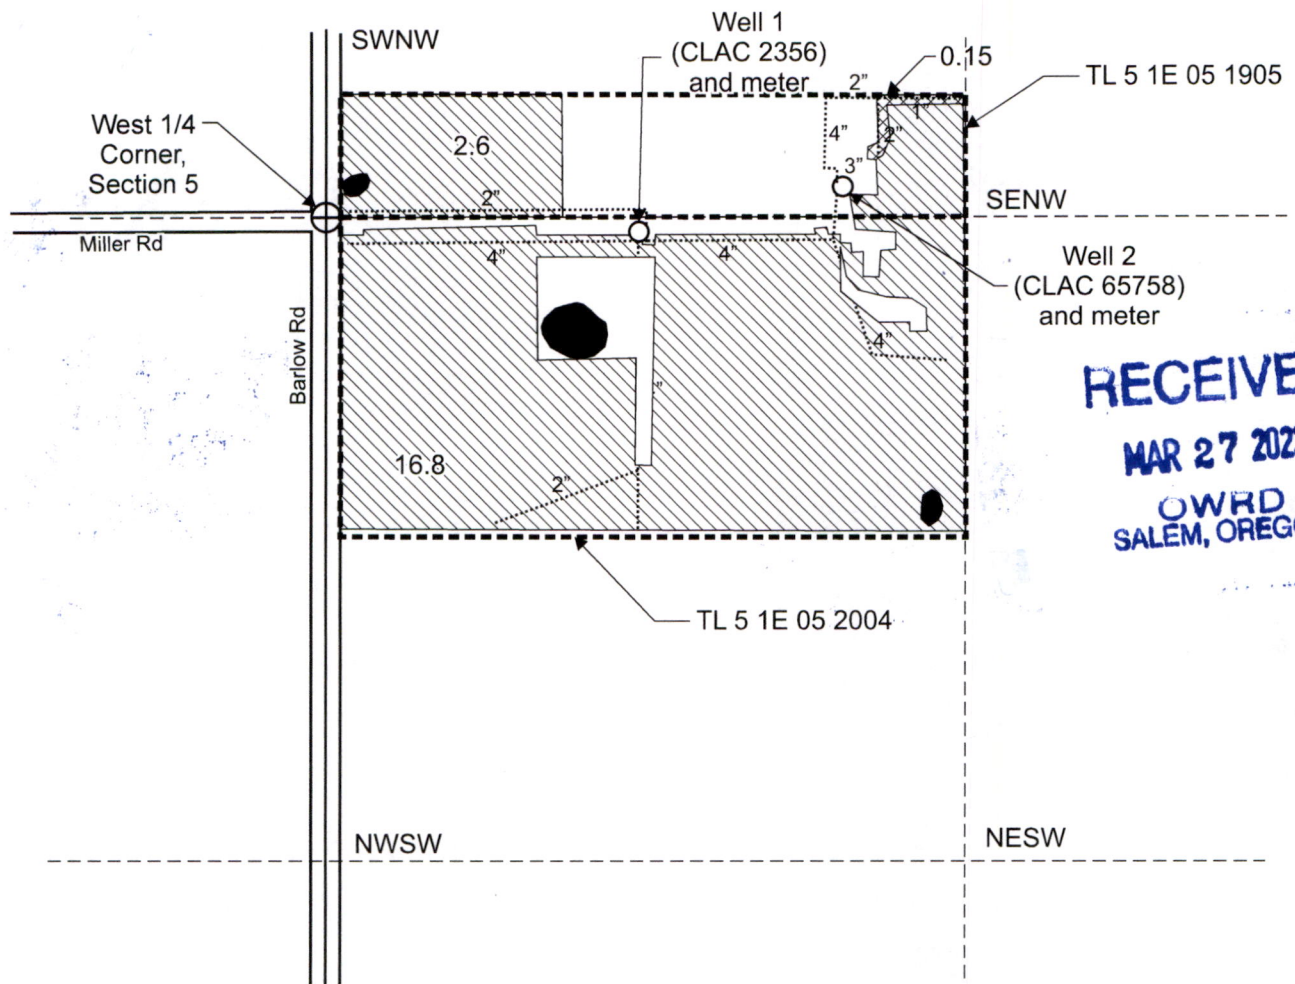

RECEIVED
MAR 27 2023
OWRD
SALEM, OREGON

Well 1 (CLAC 2356) is located 30 feet south and 650 feet east from the west 1/4 corner, Section 5.

Well 2 (CLAC 65758) is located 60 feet north and 1,070 feet east from the west 1/4 corner, Section 5.


 Area (19.4 Acres) irrigated under T-9974, formerly Certificate 55387, priority date: July 10, 1980, using Well 1 and 2.

 Area (0.15 Acres) irrigated under T-9974, formerly Certificate 55387, priority date: July 10, 1980, using Well 2 only.

----- Tax lot boundary

..... Water main line

Scale: 1" = 400'

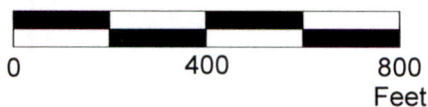

This map was prepared for the purpose of identifying the location of a water right only and is not intended to provide legal dimensions or location of property ownership lines.

Claim of Beneficial Use Map
T-9974 formerly Certificate 55387

Victoria Guevara
T.5S. R.1E. Section 5, W.M.

Pacific Hydro-Geology Inc.

02/2023