

MAR 27 2023



Oregon Water Resources Department  
725 Summer Street NE, Suite A  
Salem, Oregon 97301  
(503) 986-0900  
www.oregon.gov/OWRD

## Ownership Update for Certificated Rights Only

OWRD  
SALEM, OREGON

### NO FEES ARE REQUIRED TO SUBMIT THIS FORM

**NOTICE:** A certificate of water right typically stays with the land. To track water right ownership, the Department requests that this form be submitted to the Department. **To update multiple rights, a separate form is required for each right.** If you have any questions about this form, please contact your local watermaster, or call the Water Resources Department at (503) 986-0900.

Note: Use the [assignment](#) form to change ownership on pending applications, permits, transfers, groundwater registrations, or limited licenses.

Current Landowner Information					
Name:	Terrence W. & Debra L. Andrade				
Mailing Address:	1270 Hillcrest Dr.				
City:	Vale	State:	Or.	Zip:	97918
Phone:	(208) 599-3409	Email:	twandra3@aol.com		

Property Information							
County:	Grant	Township:	9S	Range:	26E		
Section:	15, 14						
Tax Lot #:	240A						
Street Address of Water Right:	40845 Rudio Rd., Kimberly, Or. 97848						
Water Right Information							
Application:	S-46768						
Permit:	S-34926						
Certificate:	38700						
Are all the lands associated with this water right owned by the requestor?				<input type="checkbox"/>	Yes	<input checked="" type="checkbox"/>	No
(If no, include a map showing the portion of the water right involved)							

Signature and Date		
Name of individual completing form:	Terrence W. Andrade	
Phone or email:	(208) 599-3409	Date: 3-24-2023
Signature of requestor:		

The Department does not change names on water right certificates. This form will be placed in the file for future reference only. If mailed, the Department will not provide acknowledgment of receipt.

This form can be mailed to the address above or sent by email to [wrd\\_dl\\_customerservice@water.oregon.gov](mailto:wrd_dl_customerservice@water.oregon.gov)

EXHIBIT G PAGE 1 OF 2

7/27/2021 | 9:40 PM PDT

STATE OF OREGON

COUNTY OF GRANT

CERTIFICATE OF WATER RIGHT

RECEIVED  
MAR 27 2023  
OWRD  
SALEM, OREGON

This Is to Certify, That CAMPBELL LIVESTOCK COMPANY

of Kimberly, State of Oregon, has made proof to the satisfaction of the STATE ENGINEER of Oregon, of a right to the use of the waters of North Fork John Day River

a tributary of John Day River for the purpose of irrigation of 109.1 acres

under Permit No. 34926 of the State Engineer, and that said right to the use of said waters has been perfected in accordance with the laws of Oregon; that the priority of the right hereby confirmed dates from February 24, 1970

that the amount of water to which such right is entitled and hereby confirmed, for the purposes aforesaid, is limited to an amount actually beneficially used for said purposes, and shall not exceed 1.60 cubic foot per second

or its equivalent in case of rotation, measured at the point of diversion from the stream. The point of diversion is located in the NW 1/4 SE 1/4, Section 16, SE 1/4 NE 1/4, Section 15, T. 9 S., R. 26 E., W. M. Diversion points located: 1370 feet North and 2080 feet West; 2720 feet North and 4800 feet East; both from SW Corner, Section 15. The amount of water used for irrigation, together with the amount secured under any other right existing for the same lands, shall be limited to one-fortieth of one cubic foot per second per acre, or its equivalent for each acre irrigated and shall be further limited to a diversion of not to exceed 5 acre feet per acre for each acre irrigated during the irrigation season of each year,

and shall conform to such reasonable rotation system as may be ordered by the proper state officer.

A description of the place of use under the right hereby confirmed, and to which such right is appurtenant, is as follows:

- 8.0 acres SW 1/4 NW 1/4 8.9 AC.
  - 0.9 acre NW 1/4 SW 1/4
  - Section 14
  - 2.2 acres SE 1/4 NE 1/4
  - 0.1 acre NW 1/4 SW 1/4 14.9 AC.
  - 11.8 acres NE 1/4 SE 1/4
  - 0.7 acre NW 1/4 SE 1/4
  - Section 15
  - 15.0 acres NE 1/4 SE 1/4
  - 9.8 acres NW 1/4 SE 1/4
  - 22.0 acres SW 1/4 SE 1/4
  - 33.7 acres SE 1/4 SE 1/4
  - Section 16
  - 4.9 acres NE 1/4 NE 1/4
  - Section 21
- 22.9 AC TOTAL

The right to the use of the water for the purposes aforesaid is restricted to the lands or place of use herein described.

WITNESS the signature of the State Engineer, affixed

this date. December 14, 1972

CHRIS L. WHEELER  
State Engineer

34926

38700

6


EXHIBIT G PAGE 2 OF 2

T.9S.R.26E.W.M.

RECEIVED

MAR 27 2023

OWRD  
SALEM, OREGON

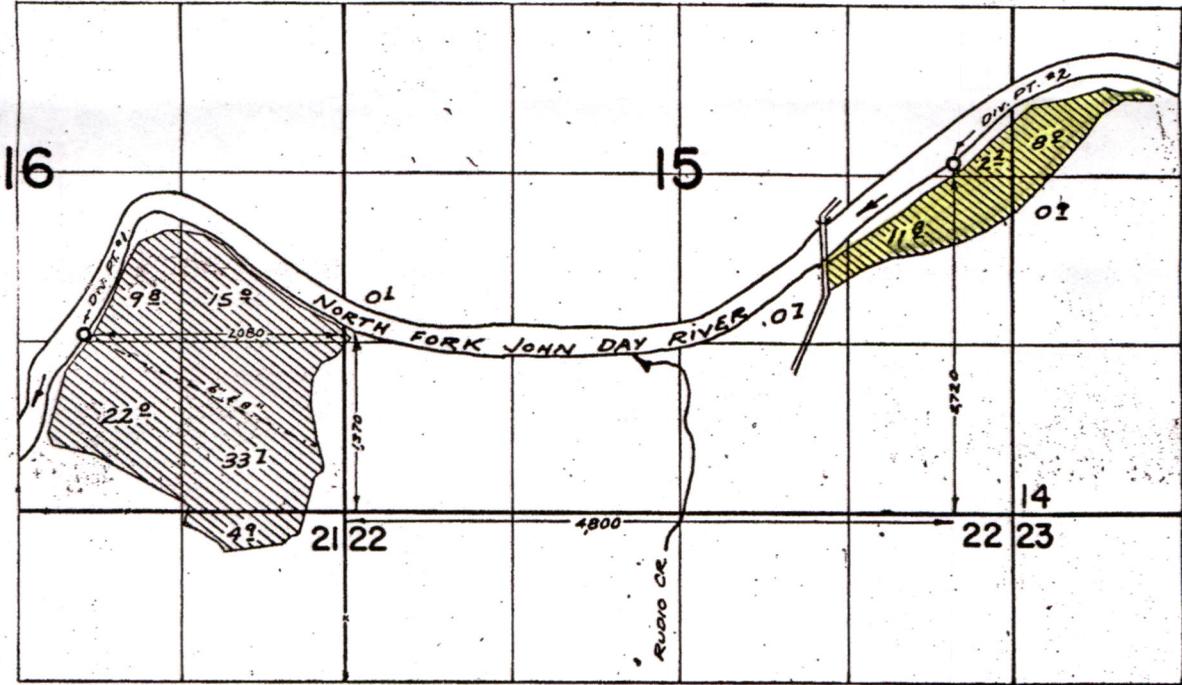

**FINAL PROOF SURVEY**  
UNDER

Application No. 46768 Permit No. 34926  
IN NAME OF

CAMPBELL LIVESTOCK COMPANY

Surveyed July 13, 1971, by R. MUCKEN

171-M