


T.5S. R.1E. Section 5, W.M.

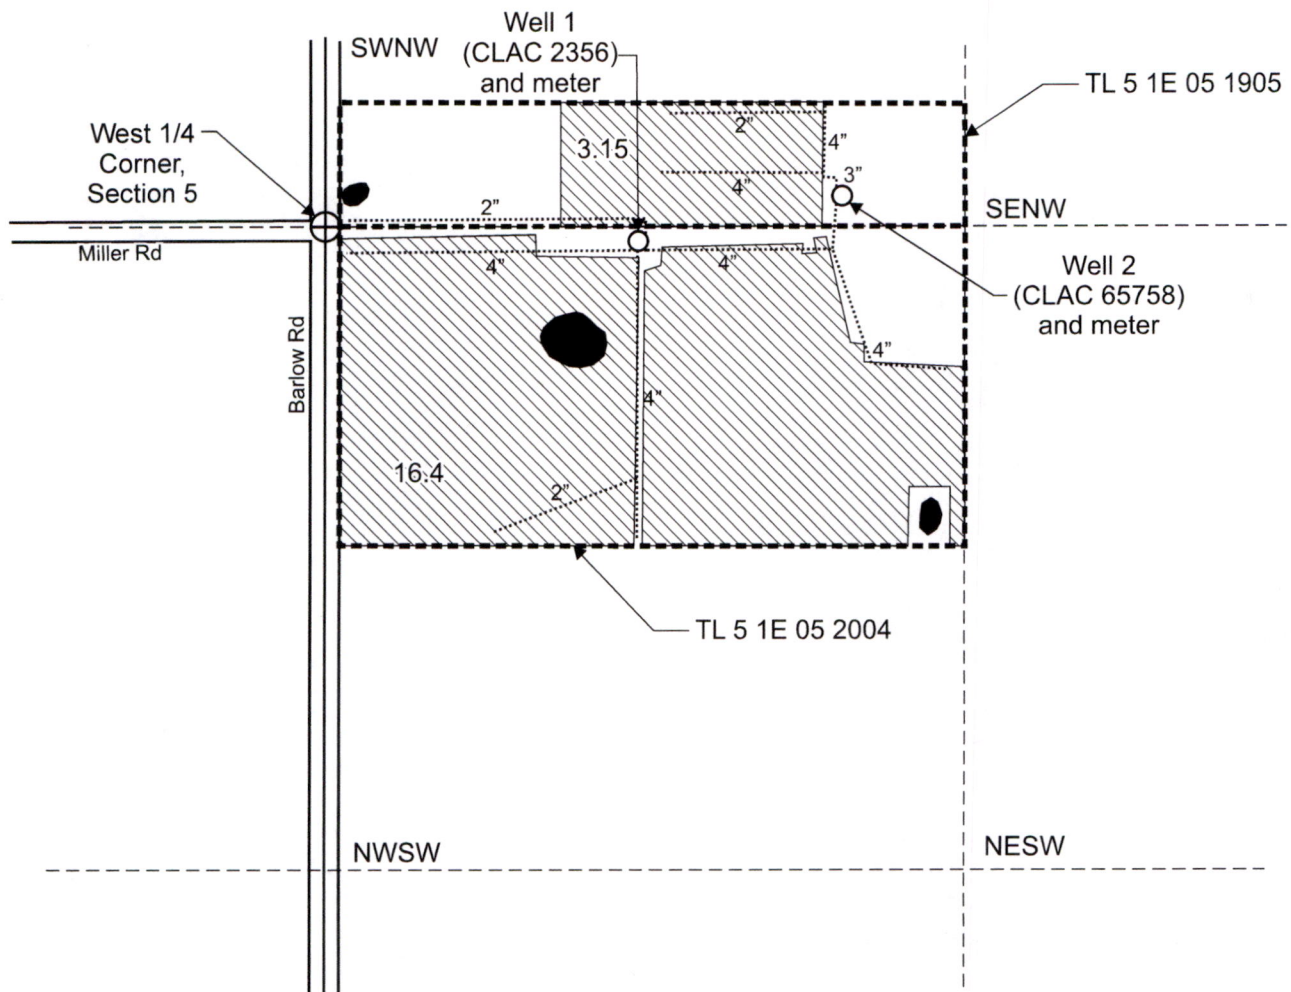

Well 1 (CLAC 2356) is located 30 feet south and 650 feet east from the west 1/4 corner, Section 5.

Well 2 (CLAC 65758) is located 60 feet north and 1,070 feet east from the west 1/4 corner, Section 5.

 Area (19.55 Acres) irrigated under Application G-15687, Permit G-15817.

----- Tax lot boundary

..... Water main line


RECEIVED

MAR 27 2023

OWRD



Scale: 1" = 400'

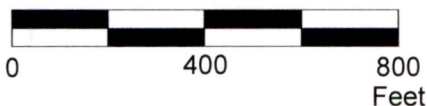

This map was prepared for the purpose of identifying the location of a water right only and is not intended to provide legal dimensions or location of property ownership lines.

Claim of Beneficial Use Map
Application G-15687, Permit G-15817

Victoria Guevara
T.5S. R.1E. Section 5, W.M.

Pacific Hydro-Geology Inc.

02/2023