


**T30S R15W, WM,
COOS COUNTY, OR**



RENEWAL DATE 12/31/2023

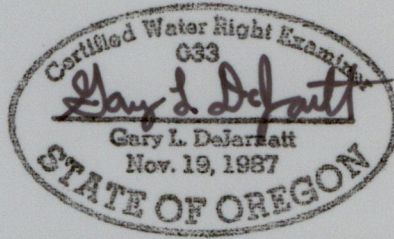

1" = 400'



POA Location:
10' N, 570' E of S 1/4 Cor Sec 12

- POA & Meter
- Pipeline
- Sump
- Section
- - - - Quarter Quarter
- Tax Lot
- POU G-16351 Cranberry Operations 9/16/1991 Priority



RECEIVED
MAR 29 2023
OWRD

<p>CLAIM OF BENEFICIAL USE MAP Russell Fraser Project #22076 Date: 2/27/2023 Ap G-12655 / Permit G-16351</p>	<p>This map is not intended to provide legal dimensions or locations of property ownership lines.</p>	<p>WATER RIGHT SERVICES, LLC PO BOX 1830, BEND, OR 97709 WWW.OREGONWATER.US CCB # 197121 johnshort@usa.com 541-389-2837</p>
--	---	--