


T3S. R.11E.

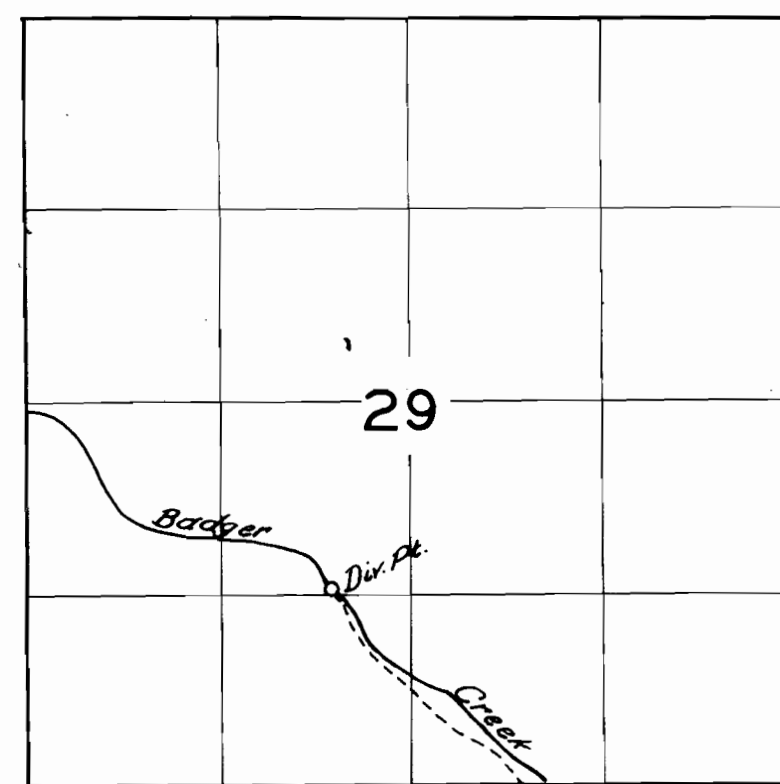

FINAL PROOF SURVEY
 IN NAME OF
BADGER IMPROVEMENT DISTRICT
 APPL. NO. R-13087 PERMIT NO. R-773
 19264 22633
 SURVEYED SEPT-OCT 1957 &
 MARCH 1958
 BY R.H. WHITBY

Y40th Creek & Res

