


T.3S. R.4E. Section 15, W.M.

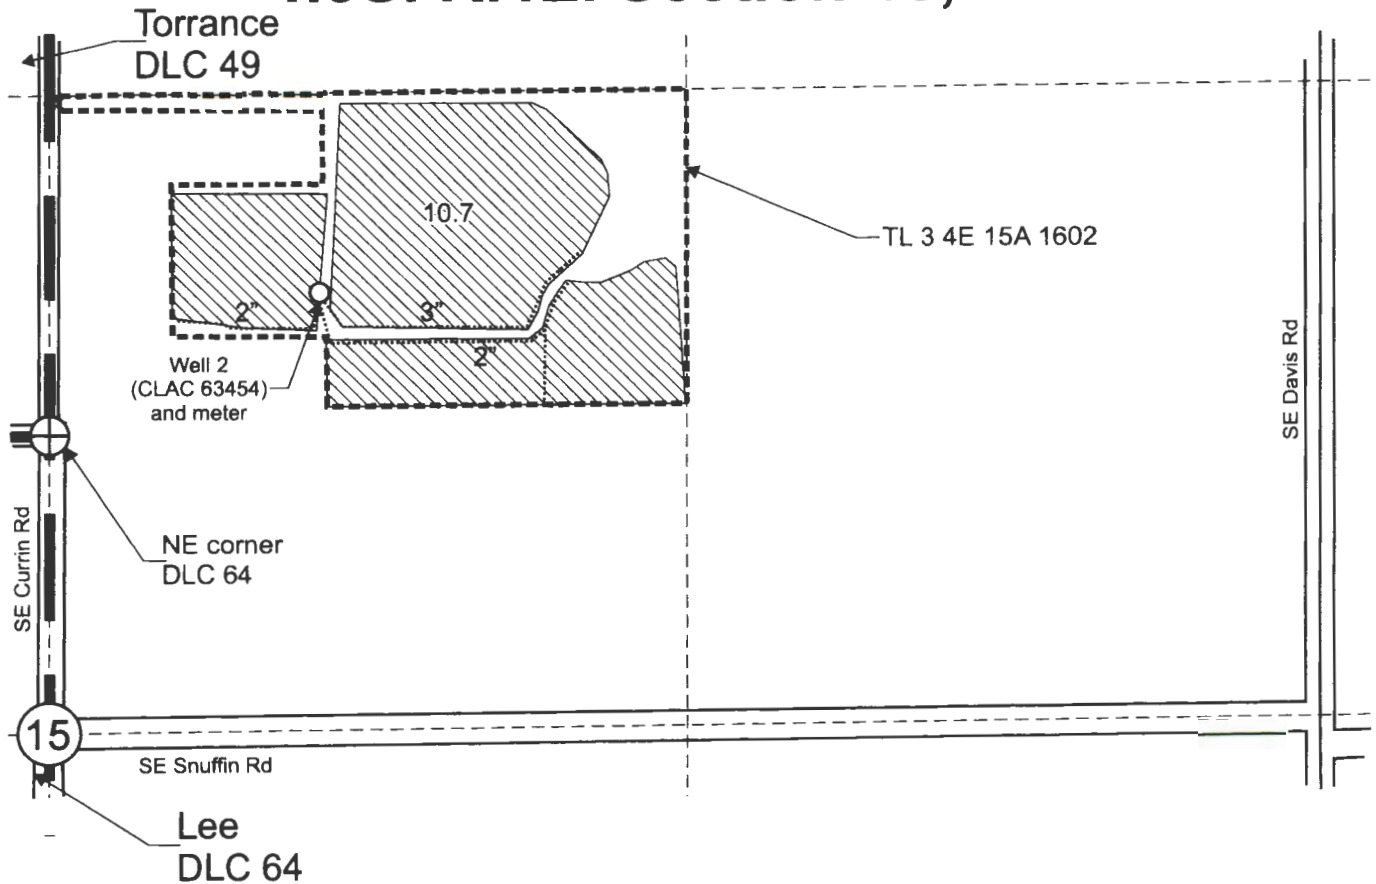

Well 2 (CLAC 63454) is located 295 feet north and 560 feet east from the NE corner, DLC 64.

 Area (10.7 Acres) of nursery operations under Application G-16473, Permit G-16035.

----- Tax lot boundary


———— Donation Land Claim boundary

..... Water main line

RECEIVED
APR 03 2023
OWRD



Scale: 1" = 400'

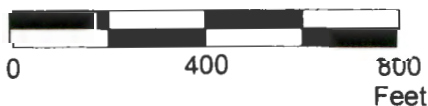

This map was prepared for the purpose of identifying the location of a water right only and is not intended to provide legal dimensions or location of property ownership lines.

Claim of Beneficial Use Map
Application G-16473, Permit G-16035

Pacific Hydro-Geology Inc.

01/2023

Rickels Tree Farm LLC
T.3S. R.4E. Section 15, W.M.