



# Havel Place LLC Claim of Beneficial Use Transfer T-11644

Township 9S, Range 2E, W.M.

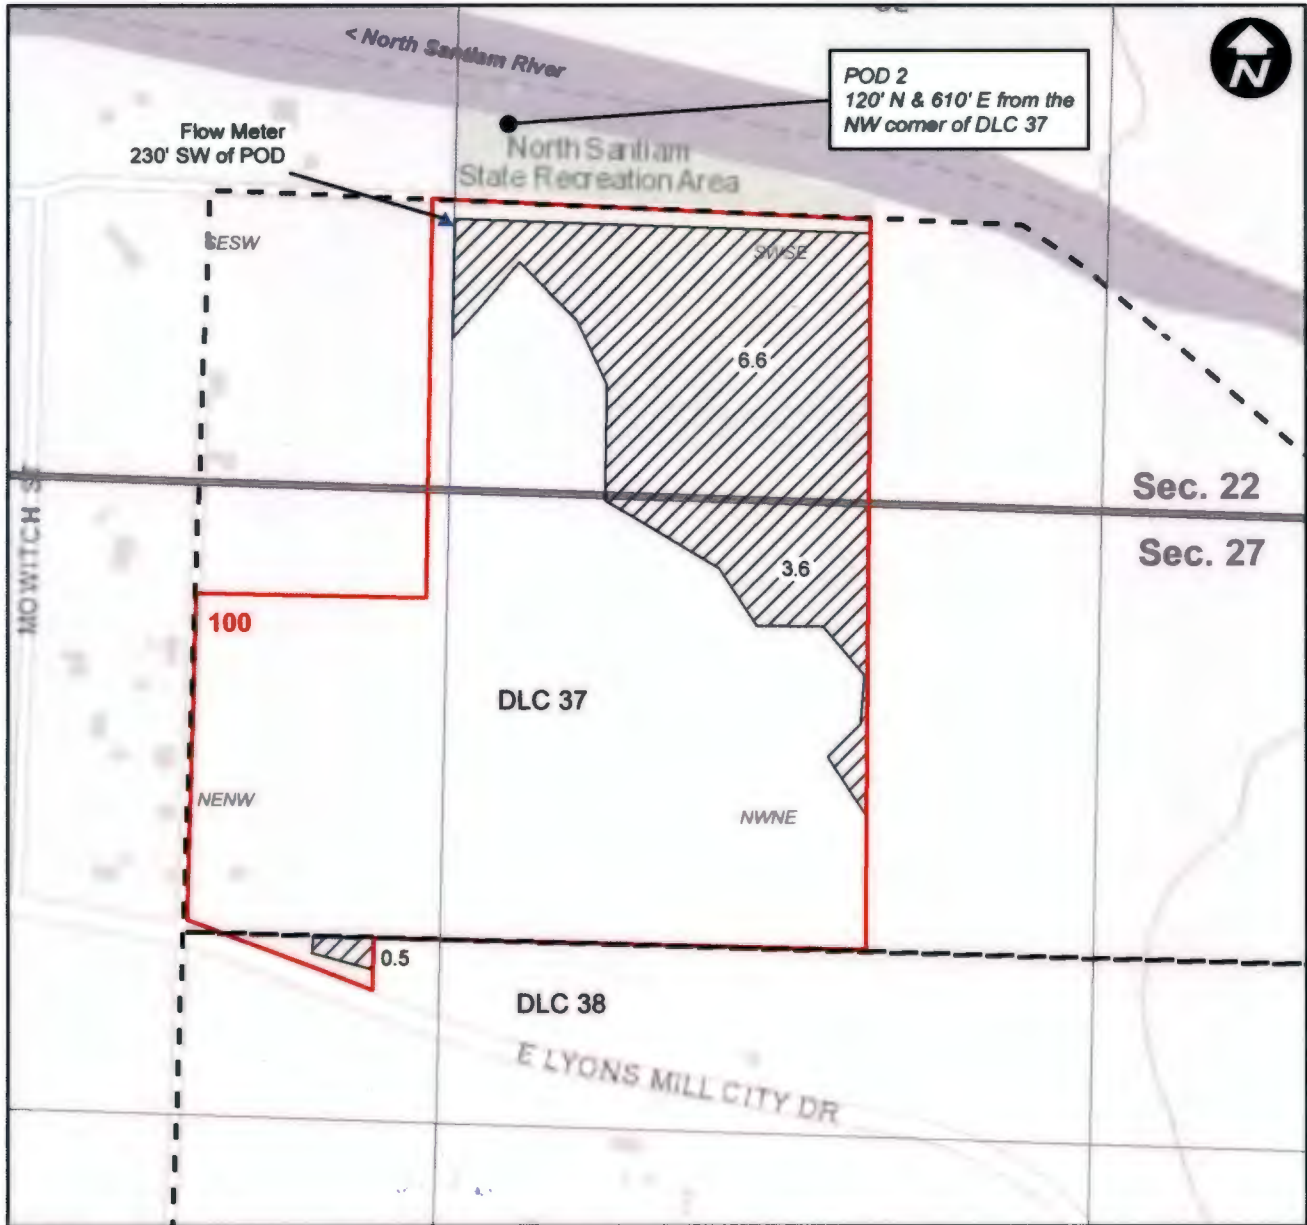

This map is not intended to provide legal dimensions or locations of property ownership lines.

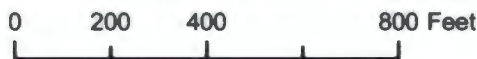

## Legend

- POU
- Taxlot
- DLC



EXPIRES: 12-31-2024

RECEIVED  
APR 05 2023