

RECEIVED

JAN 14 2000

WATER RESOURCES DEPT
SALEM, OREGON

FINAL PROOF SURVEY
Application No. R-70332
Permit No. R-12064



UPPER PITT LAKE
T. 39 S. R. 16 E. W.M.
SECTION 4
Lake County, Oregon
Fremont National Forest


The point of diversion is N.72°05'47"E,
1406.08 ft., from the 1/4 cor., sec. 5|4
T.39S., R.16E., W.M.

The center of the spillway is N.60°07'40"E,
601.41 ft., from the 1/4 cor., sec. 5|4
T.39S., R.16E., W.M.

The reservoir will contain 114 acre ft.
of water.

The area submerged by the reservoir
when filled, will be 14.23 acres.

See Lake County
Surveyors records
1/4 5|4

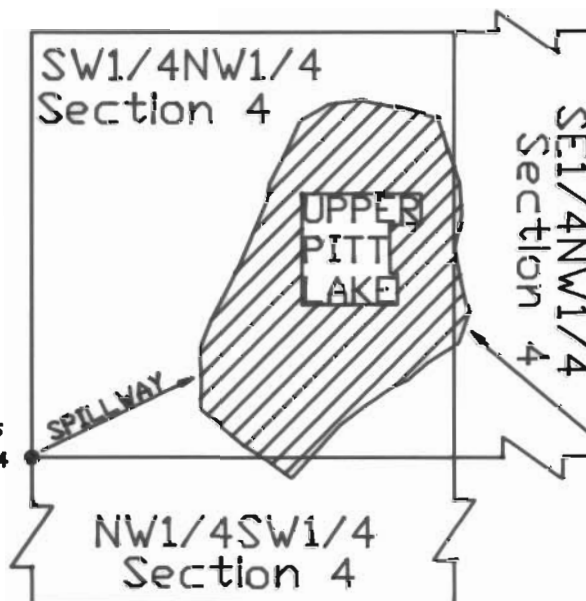

1/13/2000

SCALE IN FEET
500



0 1000

1" = 600'

1 METER = 3.2808333...3 FEET

This map was prepared for the purpose of
identifying the location of a water right
only and is not intended to provide legal
dimensions or location of property
ownership lines.