


SURVEY PERFORMED FOR
THOMAS AND JUDY LUTHER
LOCATION OF SPRING
LOCATED IN SECTION 21, T 12 S, R 11 W, W.M.
LINCOLN COUNTY ASSESSOR'S ID
(12-11-20-00 TAX LOTS 101 & 102)

SECTION CORNER

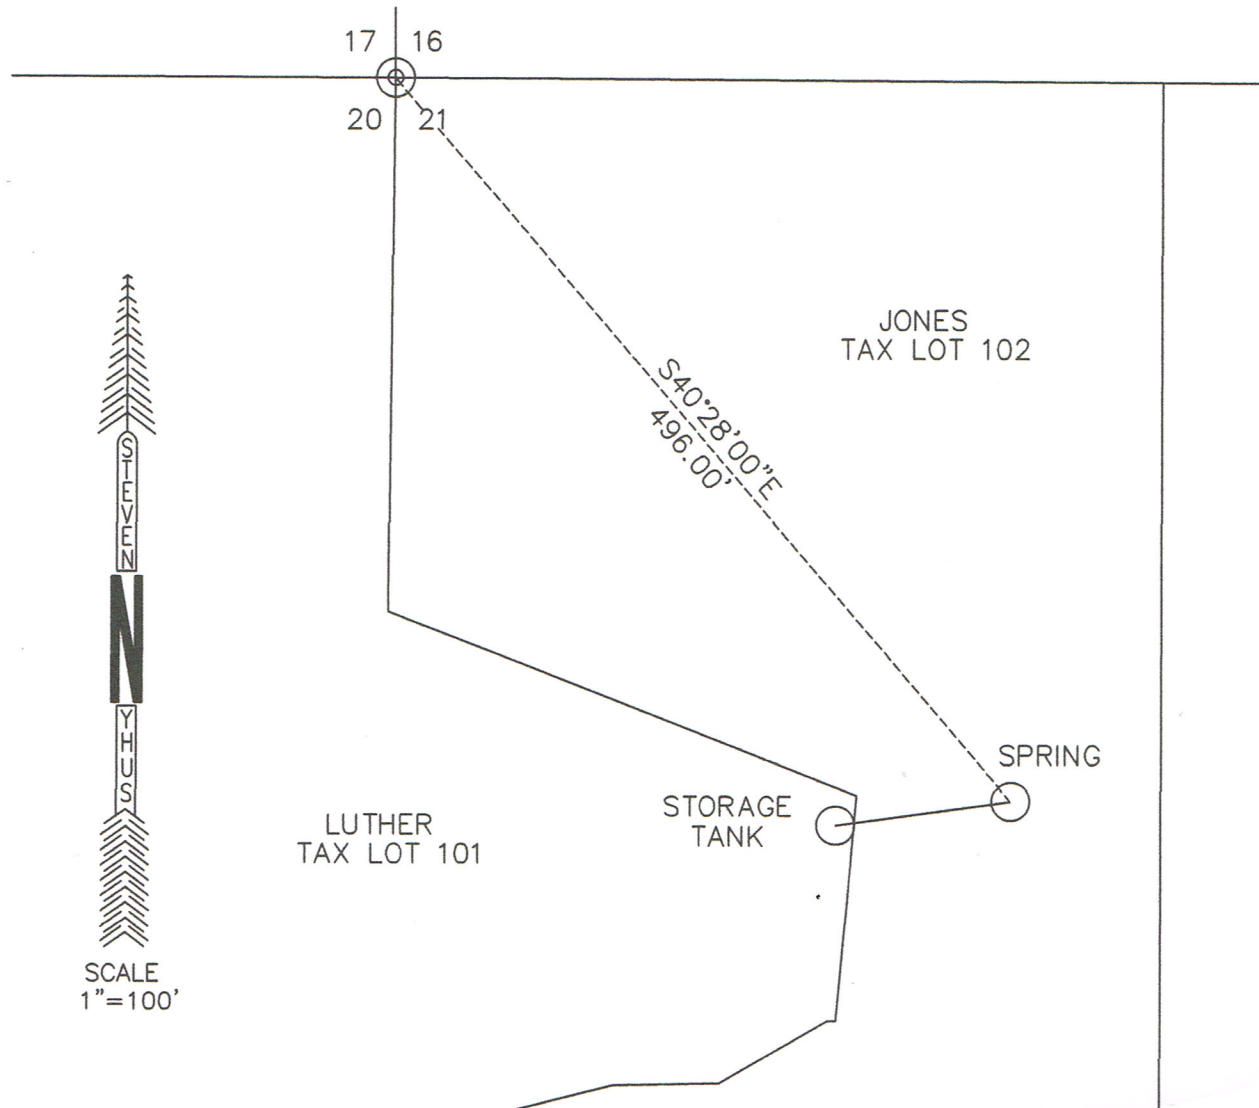

REGISTERED
PROFESSIONAL
LAND SURVEYOR

OREGON
SEPTEMBER 13, 2016
STEVEN E. NYHUS
86420PLS

RENEWAL DATE:
DEC. 31, 2024

NYHUS SURVEYING INC.

GARY NYHUS / STEVEN NYHUS / ERIC NYHUS



PROFESSIONAL LAND SURVEYORS

P.O. BOX 206

740 E. THISELL RD. TIDEWATER, ORE 97390

(541) 528-3234

CHECKED BY: GKN

DRAWN BY: SEN

DATE: 03/20/2023

SCALE: 1" = 100'

PROJECT: 23025