



Heuberger Investments LLC - Claim of Beneficial Use
 Application G-18530, Permit G-17964

Township 9S, Range 1W, W.M.

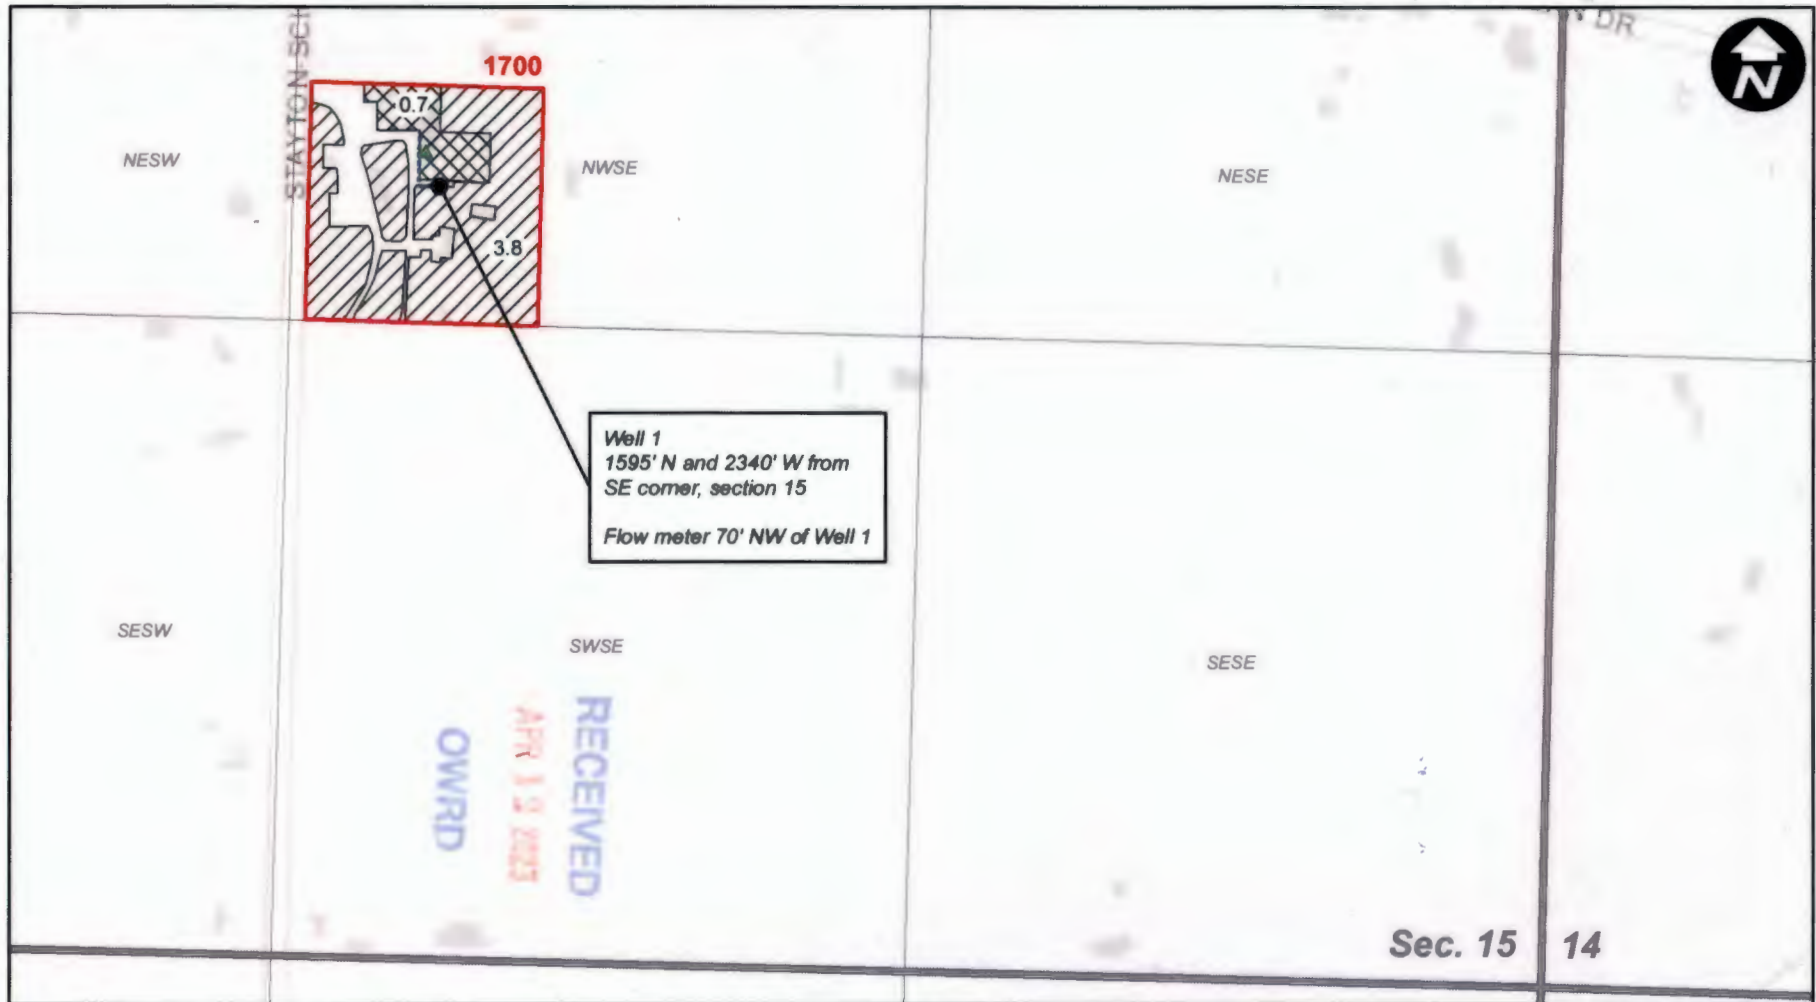

Well 1
 1595' N and 2340' W from
 SE corner, section 15
 Flow meter 70' NW of Well 1

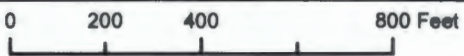

This map is not intended to provide legal dimensions or locations of property ownership lines.

Legend

- IR POU
- NU POU
- Taxlot
- Bulge Tank
- Mainline



EXPIRES: 12-31-2024