

QT/QT = NW/NW


MAP TAX LOT: 35-06-03-00-000501-00
\$ 35-06-03-00-000504-00

LAT/LONG: 42.563121, -123.393814

450 THREE PINES RD GRANTS PASS
OR 97526


RECEIVED
APR 07 2023
OWRD

← THREE PINES ROAD →

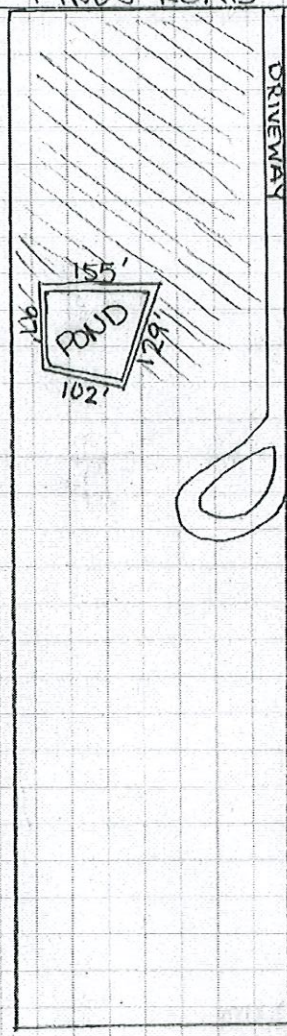

3,347.5 FEET EAST
AND 552.9 FEET SOUTH
FROM THE NORTH WEST
CORNER OF SECTION 3

.39 ACRE F.
3.91 ACRE F.
CAPACITY

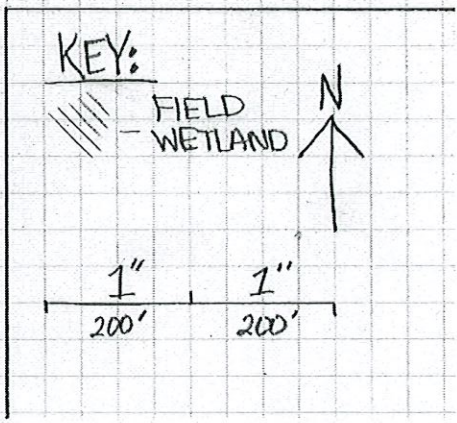

POND LOCATION FROM LAND SURVERY CORNER

EAST 3,347.5 FEET AND SOUTH 552.9 FEET FROM THE NORTHWEST CORNER OF THE NORTHWEST QUARTER OF THE NW QUARTER OF SECTION 3, TOWNSHIP 35 SOUTH, RANGE 6 WEST OF THE WILLAMETTE MERIDIAN, JOSEPHINE COUNTY, OREGON.

LATITUDE AND LONGITUDE TO CENTER OF POND:

42.563121, -123.393814

RECEIVED

APR 07 2023

OWRD