

Name Max A. and Sarah Kim Cramer
By _____
Address 3185 Madrona Lane
Medford, Oregon

Application No. GR 2513
Certificate No. GR 2380

#2

Stream Index, Page No. 15-90 ✓

FEEES PAID

Date	Amount	Receipt No.
<u>7/23/58</u>	<u>15.00</u>	<u>18159</u>

FEEES REFUNDED

Date	Amount	Check No.

Date filed July 23, 1958 8⁰⁰ AM
Tentative priority July 1946
Action suspended until _____

Well log filed _____

ASSIGNMENTS

Date	To Whom	Address	Volume	Page

CONSTRUCTION

Date for completion _____
Extended to _____
Date for application of water _____
Extended to _____

REMARKS

Awell irrigates 1-1/2 acres near Griffen Ck-Bear Ck- Jackson County
See GR- 2512 for MAP


PROSECUTION OF WORK

Form "B" filed _____
Form "C" filed _____

W.R.I.S.	
Assembled	<u>1-11-85</u> by <u>LW</u>
Entered	_____ by _____
Verified	_____ by _____

Township 37S Range 2W , W.M.

North

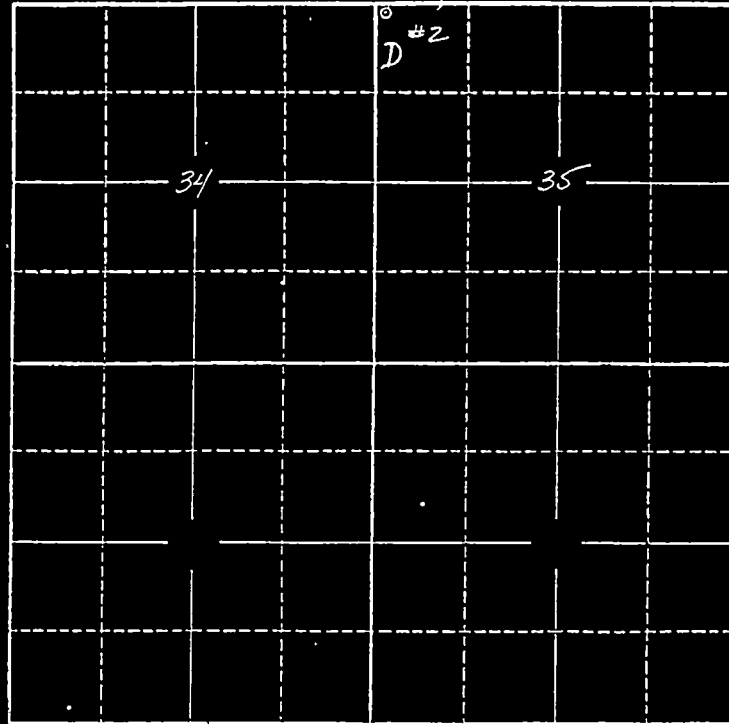

Locate well and acreage of irrigated land on plat.

Scale: 2" = 1 Mile

STATE OF OREGON

County of W. T. 250 } ss.

WI, ALVA L. RAMLO ^{no} 570.14 him J. FRANK, being first duly sworn, do hereby certify that I have read the foregoing Registration Statement and that all of the items therein contained are true to the best of my knowledge and belief.

Max O. Craven
Ladd Kinn Craven
(Signature of Registrant)

Subscribed and sworn to before me this 27 day of July, 1951

My commission expires Dec. 27 1959

GR-2513

March 27, 1959

Max A. and Sarah Kim Cramer
3185 Madrona Lane
Medford, Oregon

Dear Sir and Madam:

GR-2513
GR-2380