

Name Max A. and Sarah Kim Cramer

By _____

Address 3185 Madrona Lane

Medford, Oregon

Date filed July 23, 1958 8:00 AM

Tentative priority March 1946

Action suspended until _____

Well log filed _____

CONSTRUCTION

Date for completion _____

Extended to _____

Date for application of water _____

Extended to _____

PROSECUTION OF WORK

Form "B" filed _____

Form "C" filed _____

Application No. GR 2512

Certificate No. GR 2379

#1

FEEES PAID

Date	Amount	Rec
7/23/58	15.00	181

Stream Index, Page No. 15-90 ✓

FEEES REFUNDED

Date	Amount	Ch

ASSIGNMENTS

Date	To Whom	Address	Volume

REMARKS

*(Griffen Ck)
A well irrigates 2.0 acres near Bear Ck - Rogue River - Jackson County*

W.R.I.S.


Assembled 1-11-85 by LJ

Entered _____ by _____

Verified _____ by _____

Township 37S Range 2W, W.M.

North

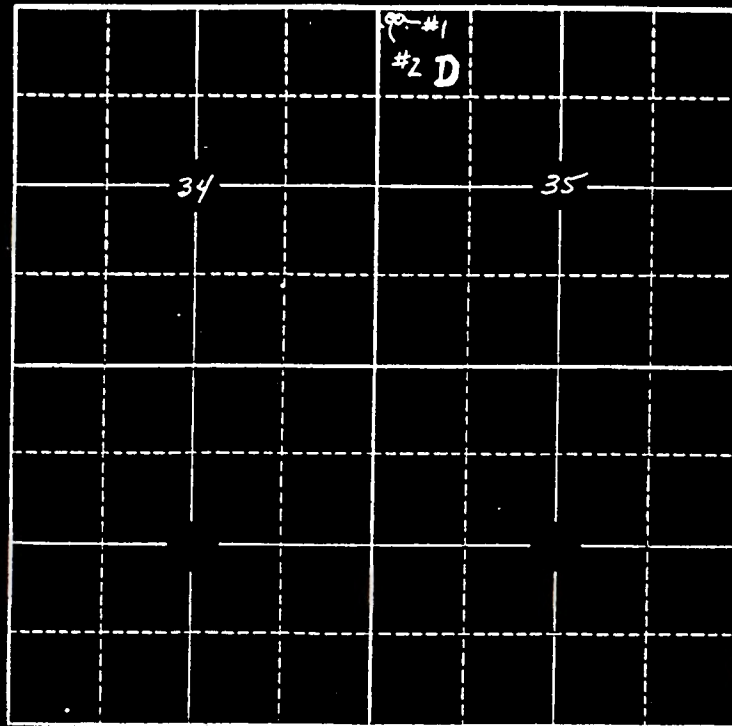

Locate well and acreage of irrigated land on plat.

Scale: 2" = 1 Mile

STATE OF OREGON

County of Jackson

} ss.

WE I, MAX J. CRAMER AND SARAH KIM CRAMER being first duly sworn, do hereby certify that I have read the foregoing Registration Statement and that all of the items therein contained are true to the best of my knowledge and belief.

Max J. Cramer
Sarah Kim Cramer
(Signature of Registrant)

Subscribed and sworn to before me this 23rd day of July, 1955

My commission expires May 27 1959

Quentin S. McCune

(Section)

27 26
34 35

S 89° 51' 15" W
390.0'

(Madrona Lane)

600'

SE cor
DCL 75

NE cor
DCL 78

DCL 78

(Casino Road)

346.02'

N 09° 14' 5" W

House

Total -
3.1 acres

#2 #1

N 35° 08' 240'
N 40° 00' 250'


N 58° 00' W 282'
N 52° 00' W 320'

S 89° 55' 30" E 390'

347.53'

S 54° 07' 45" W

Scale: 1" = 60'

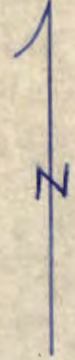

GR 2512

Property & wells of
M.A. & Sarah Kim Cramer
5185 Madrona Lane
Medford Jackson County Oregon

RECORDED
JUL 23 1958
STATE REC DEPT
SALEM, OREGON

GR-2512

March 27, 1959

Max A. and Sarah Kim Cramer
3185 Madrona Lane
Medford, Oregon

Dear Sir and Madam:

GR-2512
GR-2379

GR 2512
GR 2513

August 8, 1958

Mr. Max A. Cramer
3185 Madrona Lane
Medford, Oregon


Dear Mr. Cramer:

18159 and 18158

2 30

GR 2512 and GR 2513

Wells of
M.A. & Sarah Kim Cramer
3185 Madrona Lane
Medford Jackson County Oregon

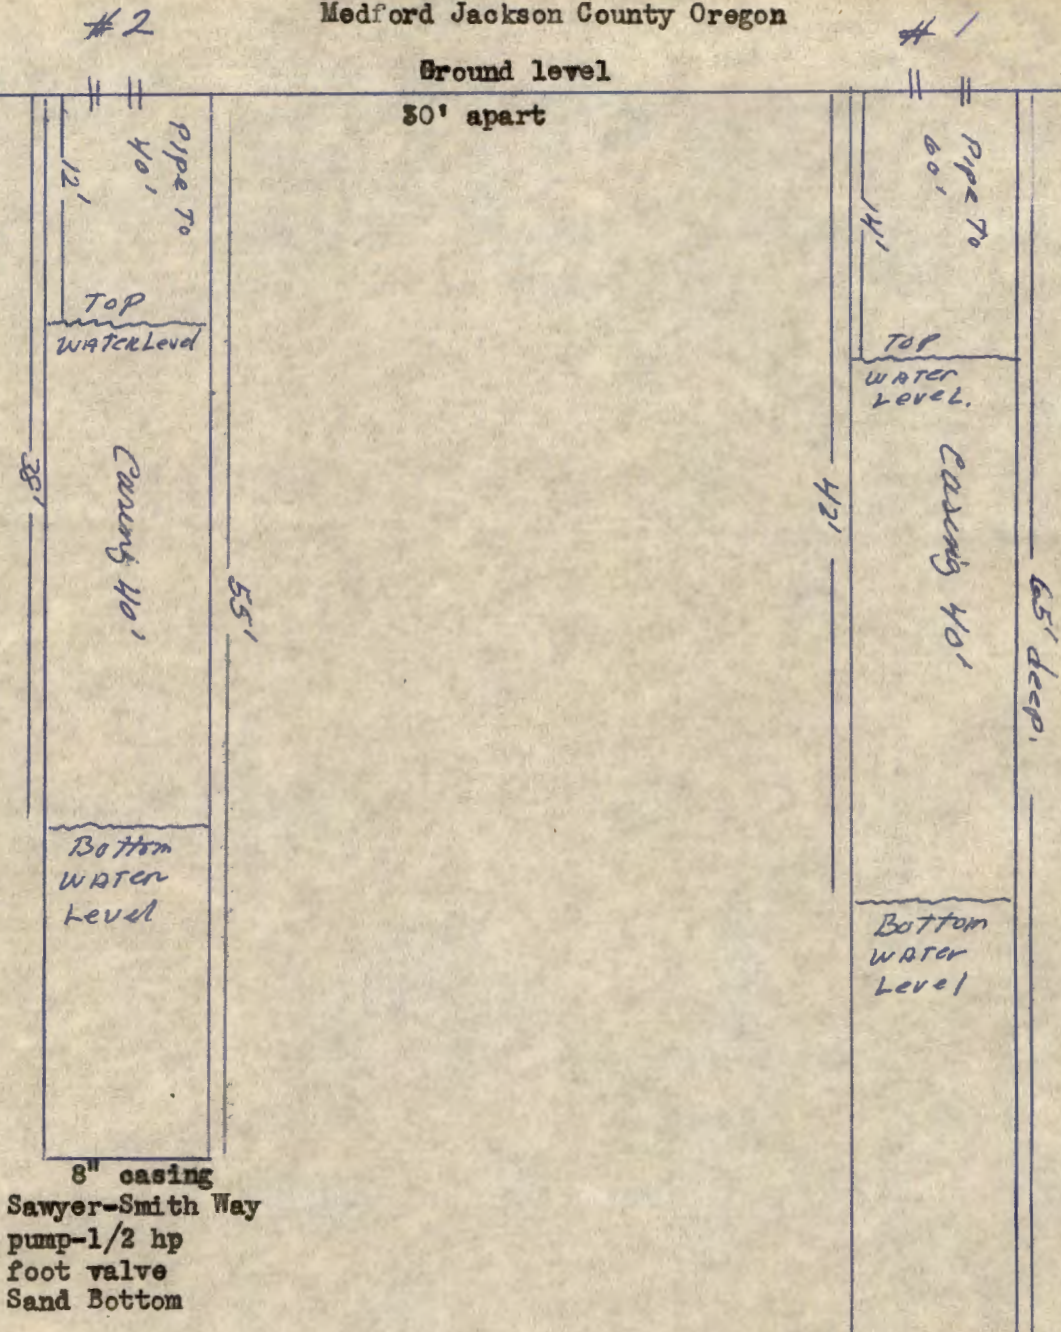

8" casing
Sawyer-Smith Way
pump-1/2 hp
foot valve
Sand Bottom

8" casing
Gravel Bottom
Pacific Pump
S# 10298
1hp-foot valve

GR-2512

RECEIVED
JUL 23 1958
STATE ENGINEER
SALEM, OREGON

GR-2512

March 14, 1957

Mr. M.A. Cramer
3185 Madrona Lane
Medford, Oregon

Dear Mr. Cramer:

In compliance with your request of March 7, 1957, we are sending you a copy of the pamphlet "Rules on regulations relative to the appropriation and use of ground water," an instruction sheet which describes the purpose and procedure for well registration, and a registration statement form.

Additional registration statement forms are available upon request.

Very truly yours,

LEWIS A. STANLEY
State Engineer

By

Jack E. Sceva, Geologist

JES:lg

3

3185 Madrona Lane
Medford Oregon
3-7-1957

State of Oregon
State Engineer
Water Resources Department
Salem Oregon

RECEIVED
MAR 11 1957
STATE ENGINEER
SALEM, OREGON

Gentlemen:

I read in the Medford Mail Tribune this evening a communication from your office advising the general public of their obligations under the new State of Oregon Water Code.

As a matter of information please advise if under the following conditions It will be necessary for me to file for water rights on my property.

I have about two and a half acres located in Jackson County in the Oak Grove District. I have lived here since 1944 and have two wells that have been used by my family and myself since that time. One well is about 90 feet deep and the other is 85 feet deep and both have deep well pumps. I also have another well of about 30 feet in depth with a shallow well pump which is also in use.

From the above wells we have domestic water supply for our home and a small garage apartment. We also sprinkle and irrigate our lawn of about one acre. We also have shrubs and trees which we also irrigate and a small orchard of about one acre consisting of fruit trees. During the summer we operate our wells and pumps about 18 hours a day in order to properly water our lawn and trees and for domestic use.

Of course this amounts to much over 5000 gallons per day and I believe the article I have reference to said that if you use over 5000 gallons per day or irrigate over 1/2 acre of lawn an application must be made. Your cooperation in advising me of the status of my particular needs will be most sincerely appreciated. We must use about 30000 gallons per day in the summer time.

Very truly yours,



M.A. Cramer