



Claim of Beneficial Use - LGC Twin Cedars LLC

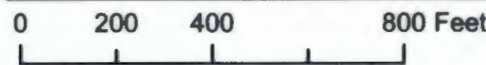

Application G-15152, Permit G-14025

Township 12S, Range 2W, W.M.

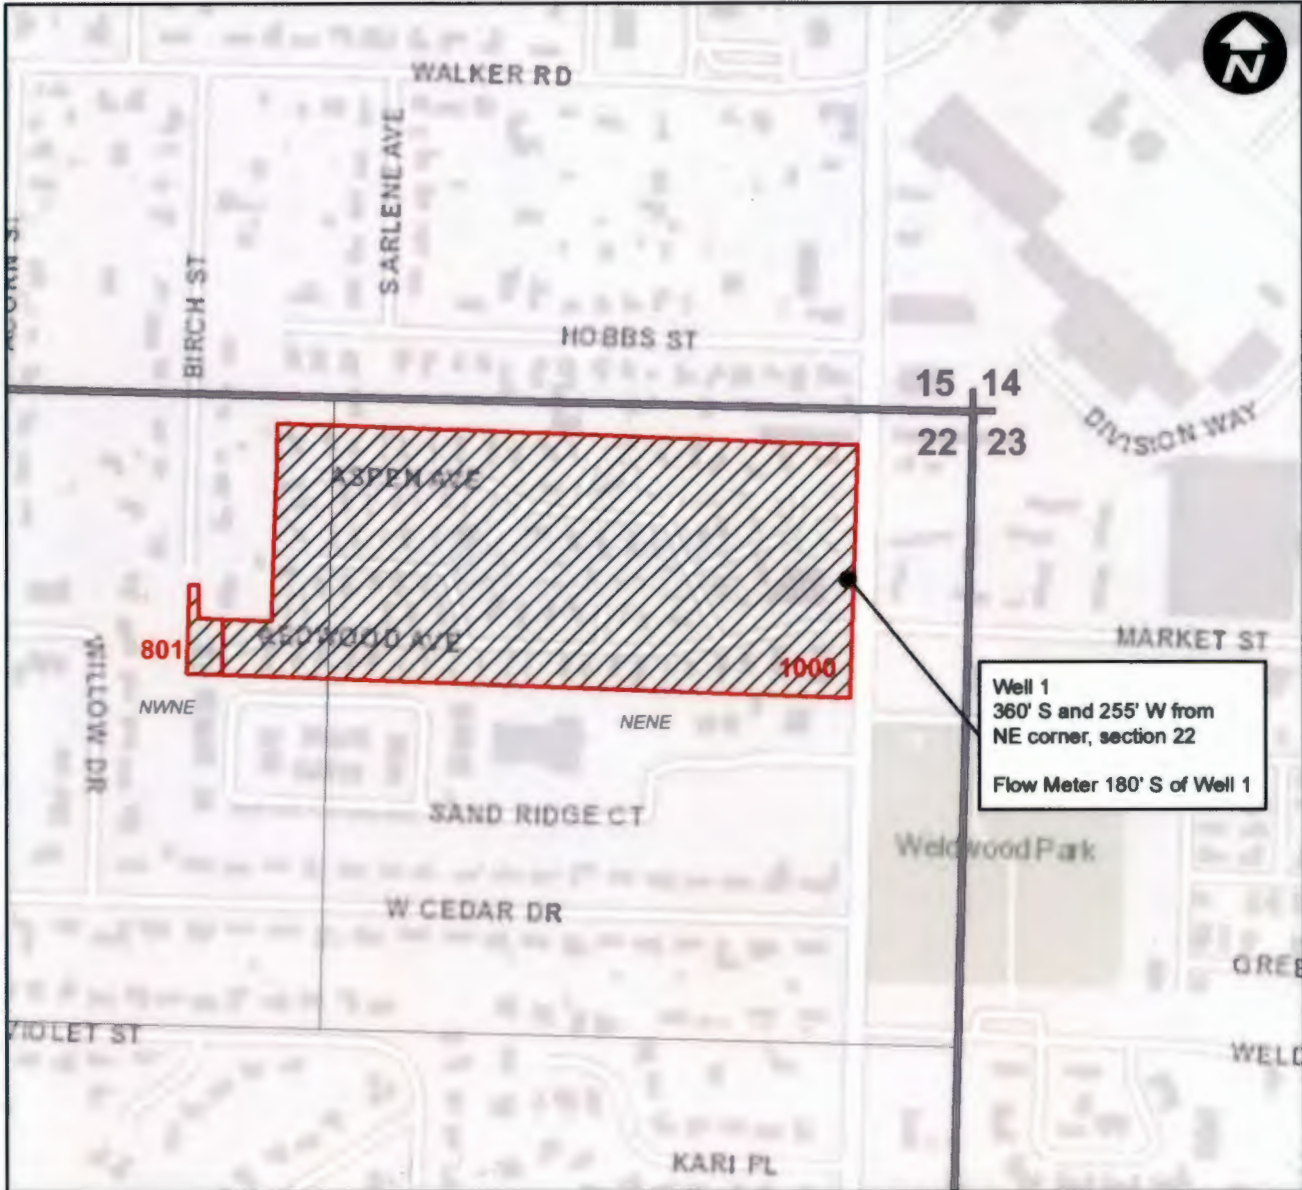

This map is not intended to provide legal dimensions or locations of property ownership lines.

Legend

-  Taxlot
-  POU

RECEIVED
 APR 24 2011
 OWRD



EXPIRES: 12-31-2024