

Tp 3 S

R 39 E

MAP

SHOWING LANDS IRRIGATED
From

CATHERINE CREEK AS

Included in United States District Court Decree
in re

AMALGAMATED SUGAR Co vs HEMPE et al

Compiled from special field inspections and the
State Engineers Maps by Rhea Luper
Oct 1917
Scale 4"=1 mile


LEGEND

Crosshatching indicates area irrigated
Direction of crosshatching with name indicates ownership
Color with name of ditch indicates lands supplied from
the same ditch.



R 40 E

Tp 4 S

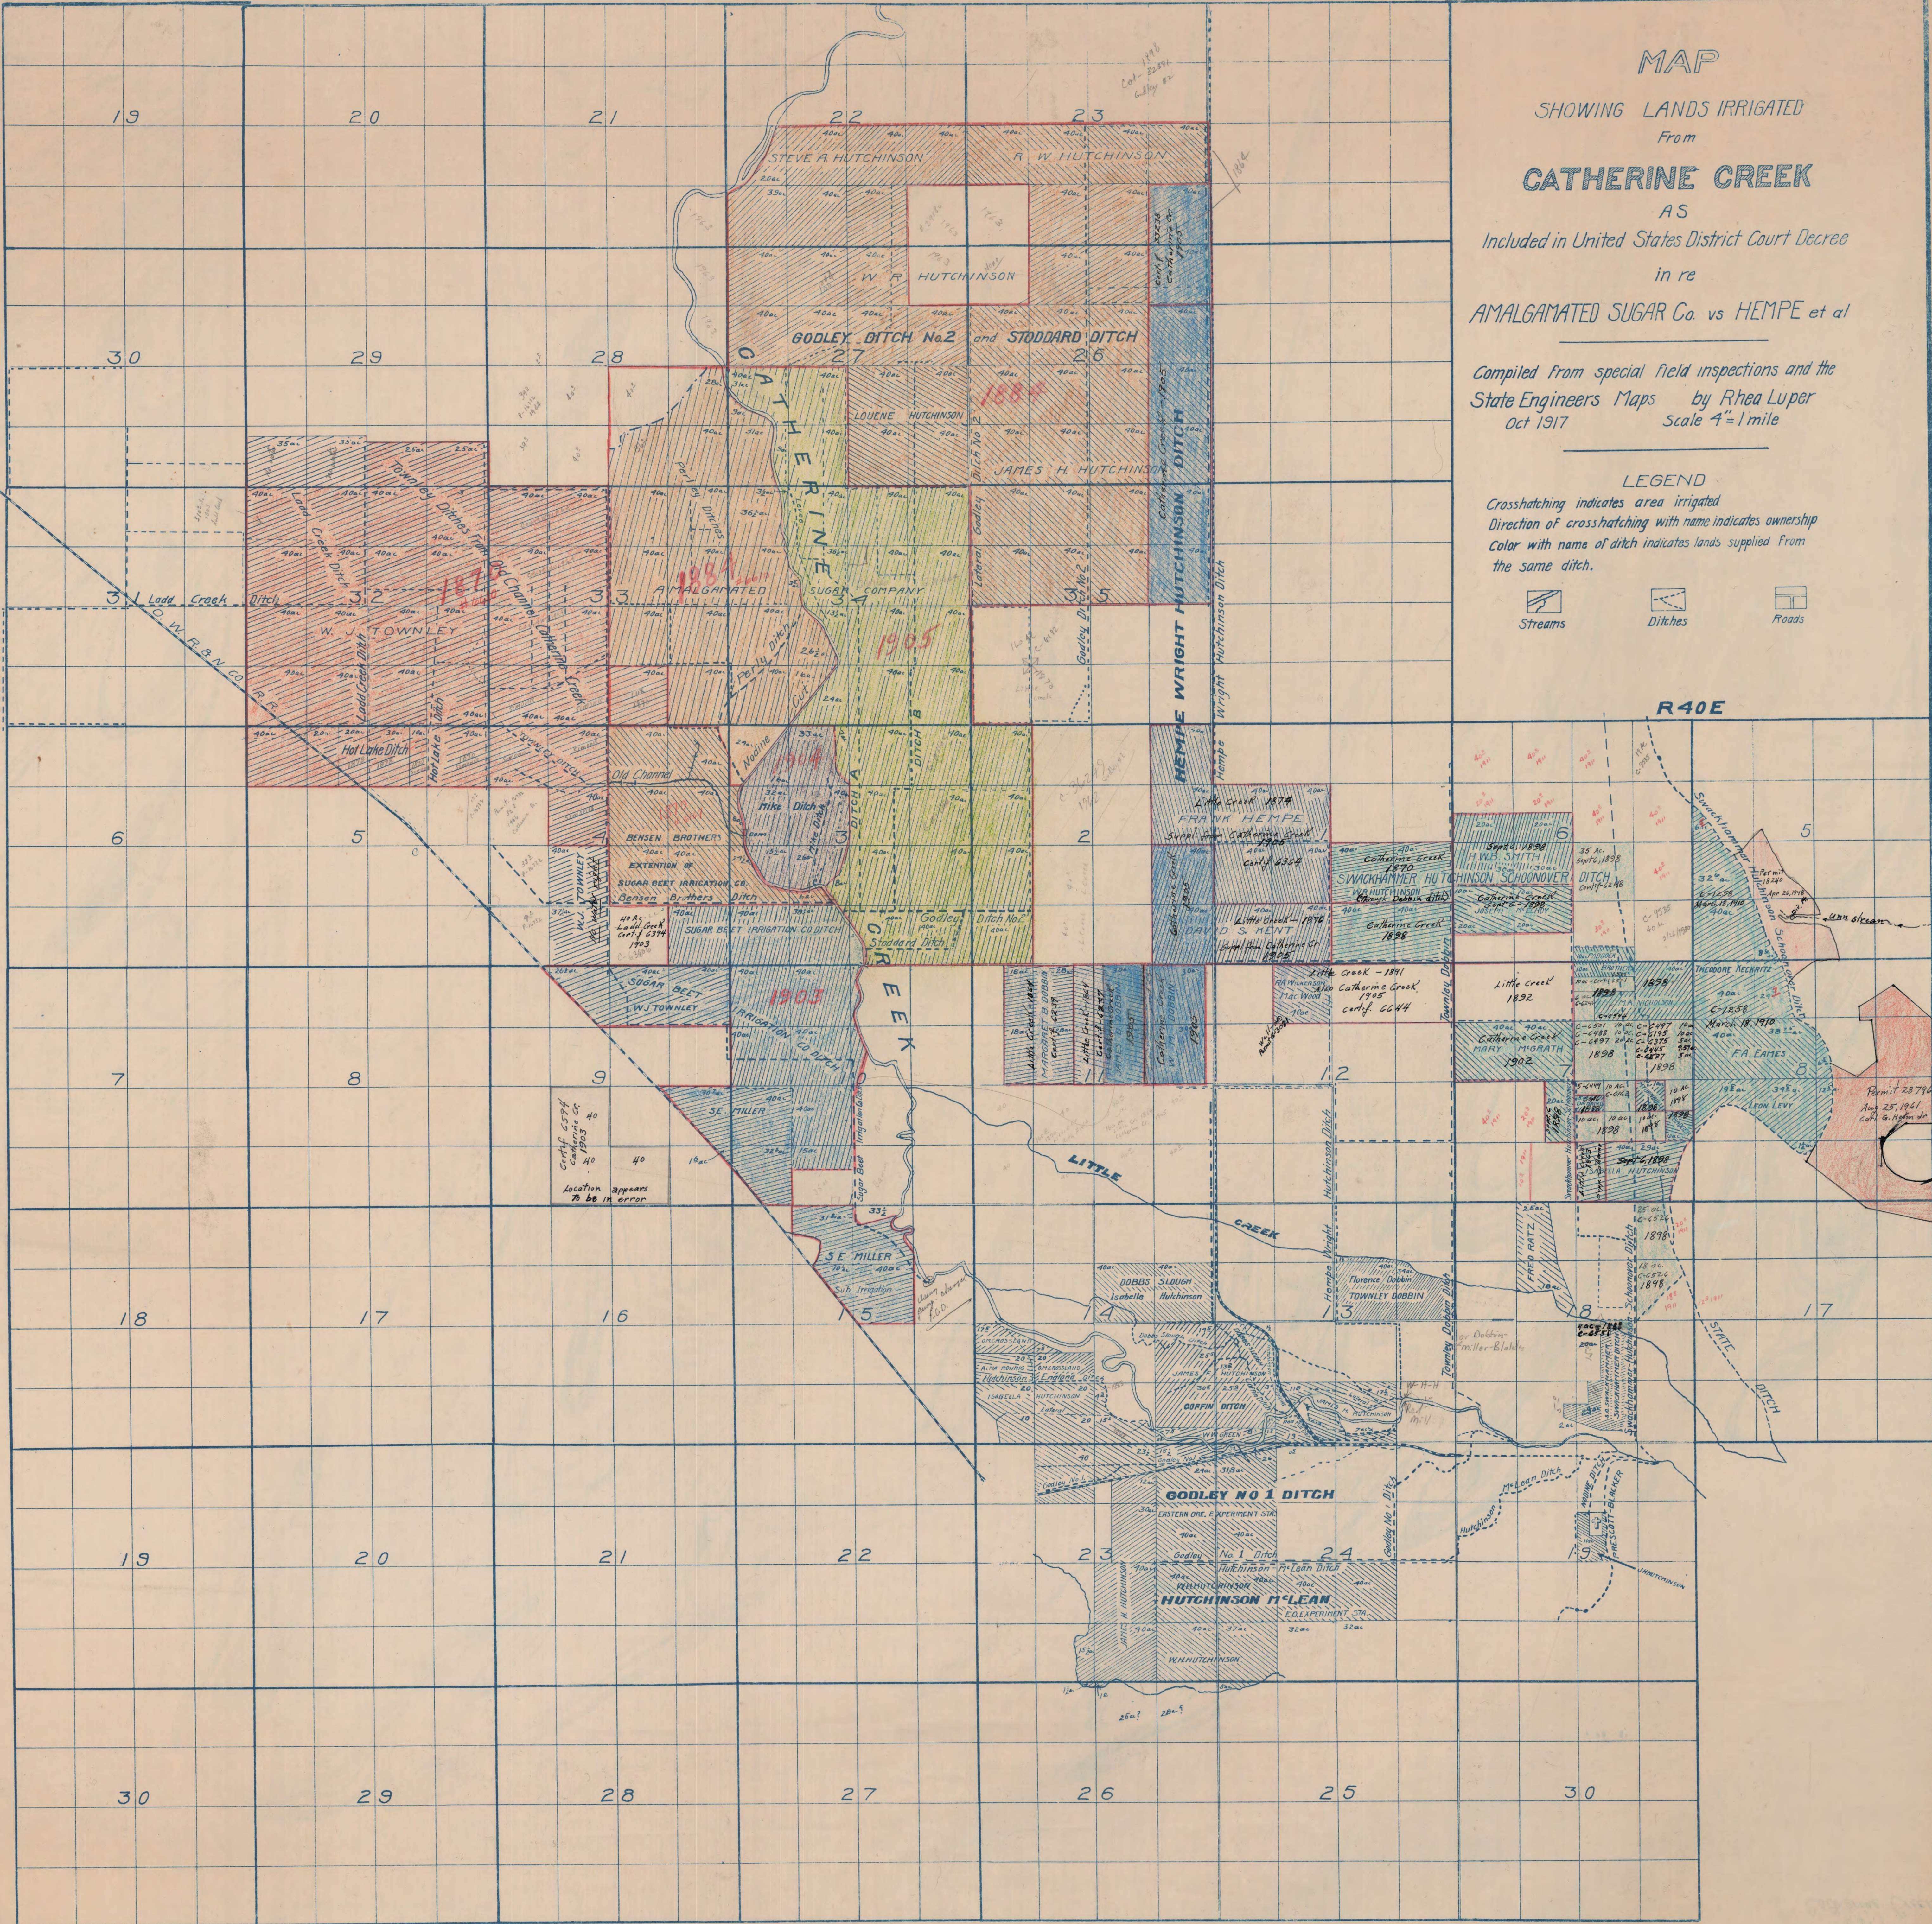

19

20

21

22

23

30

29

28

27

26

6

5

4

3

2

7

8

9

10

11

18

17

16

15

14

19

20

21

22

23

24

30

29

28

27

26

25

30