


RECEIVED
MAY 02 2023
OWRD

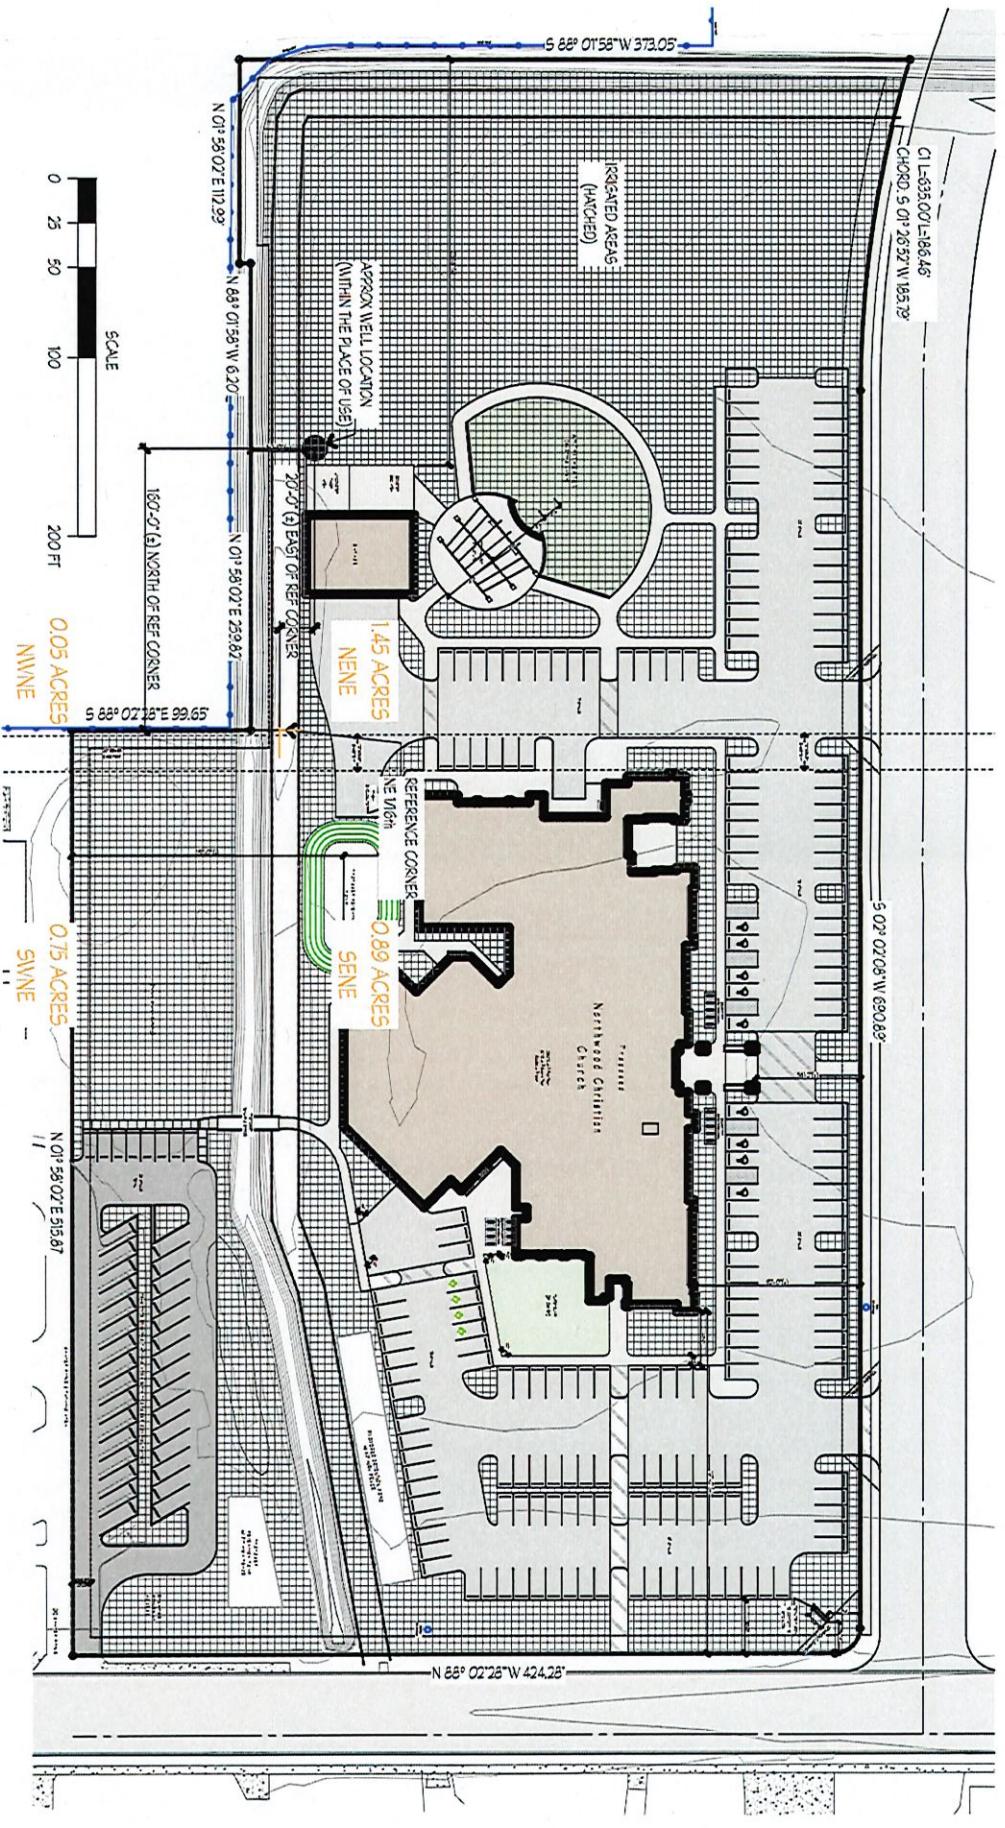


PLANTING AREA CALCULATIONS

LANDSCAPE REQUIRED	STANDARD	15% OF SITE
PROPOSED	100,000 SF (45% OF SITE)	15,000 SF (14% OF SITE)

INTERIOR PLANTING ISLANDS	15% OF SITE
PROPOSED	15,000 SF
FUTURE BUILDING LOT	18,000 SF
PROPOSED	5,233 SF
REGO ISLAND LANDSCAPE	4,033 SF
PROPOSED	1,200 SF
REGO ISLAND LANDSCAPE	1,200 SF
PROPOSED	403 SF
FUTURE BUILDING LOT LANDSCAPE	403 SF
REGO TREE PER 100 SF PROVIDED	9


TOTAL IRRIGATED AREA
IS 3.14 ACRES

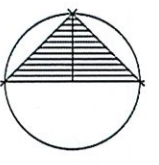

WELL LOCATION

SCALE: 1" = 100'
T 175 R 3 W SEC 25 QTR SEC 11 TAX LOT 02300

Superseding

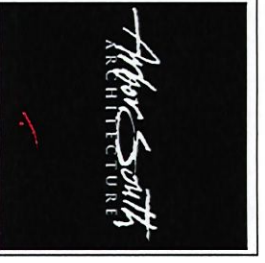

380 Lincoln Street
Eugene, Oregon 97401
Phone: 541-344-3332
www.arthur-smith.com

PROJECT
NORTHWOOD
CHRISTIAN CHURCH

2425 V STREET
SPRINGFIELD OR

RESEX
Site Plan - Well

JOB NO
0520

DATE
02 May 2023

DRAWN BY
Bill

CHECKED BY
Bill

REVISION



MEMBERS OF THE
AMERICAN INSTITUTE
OF ARCHITECTS

SHEET NO

0