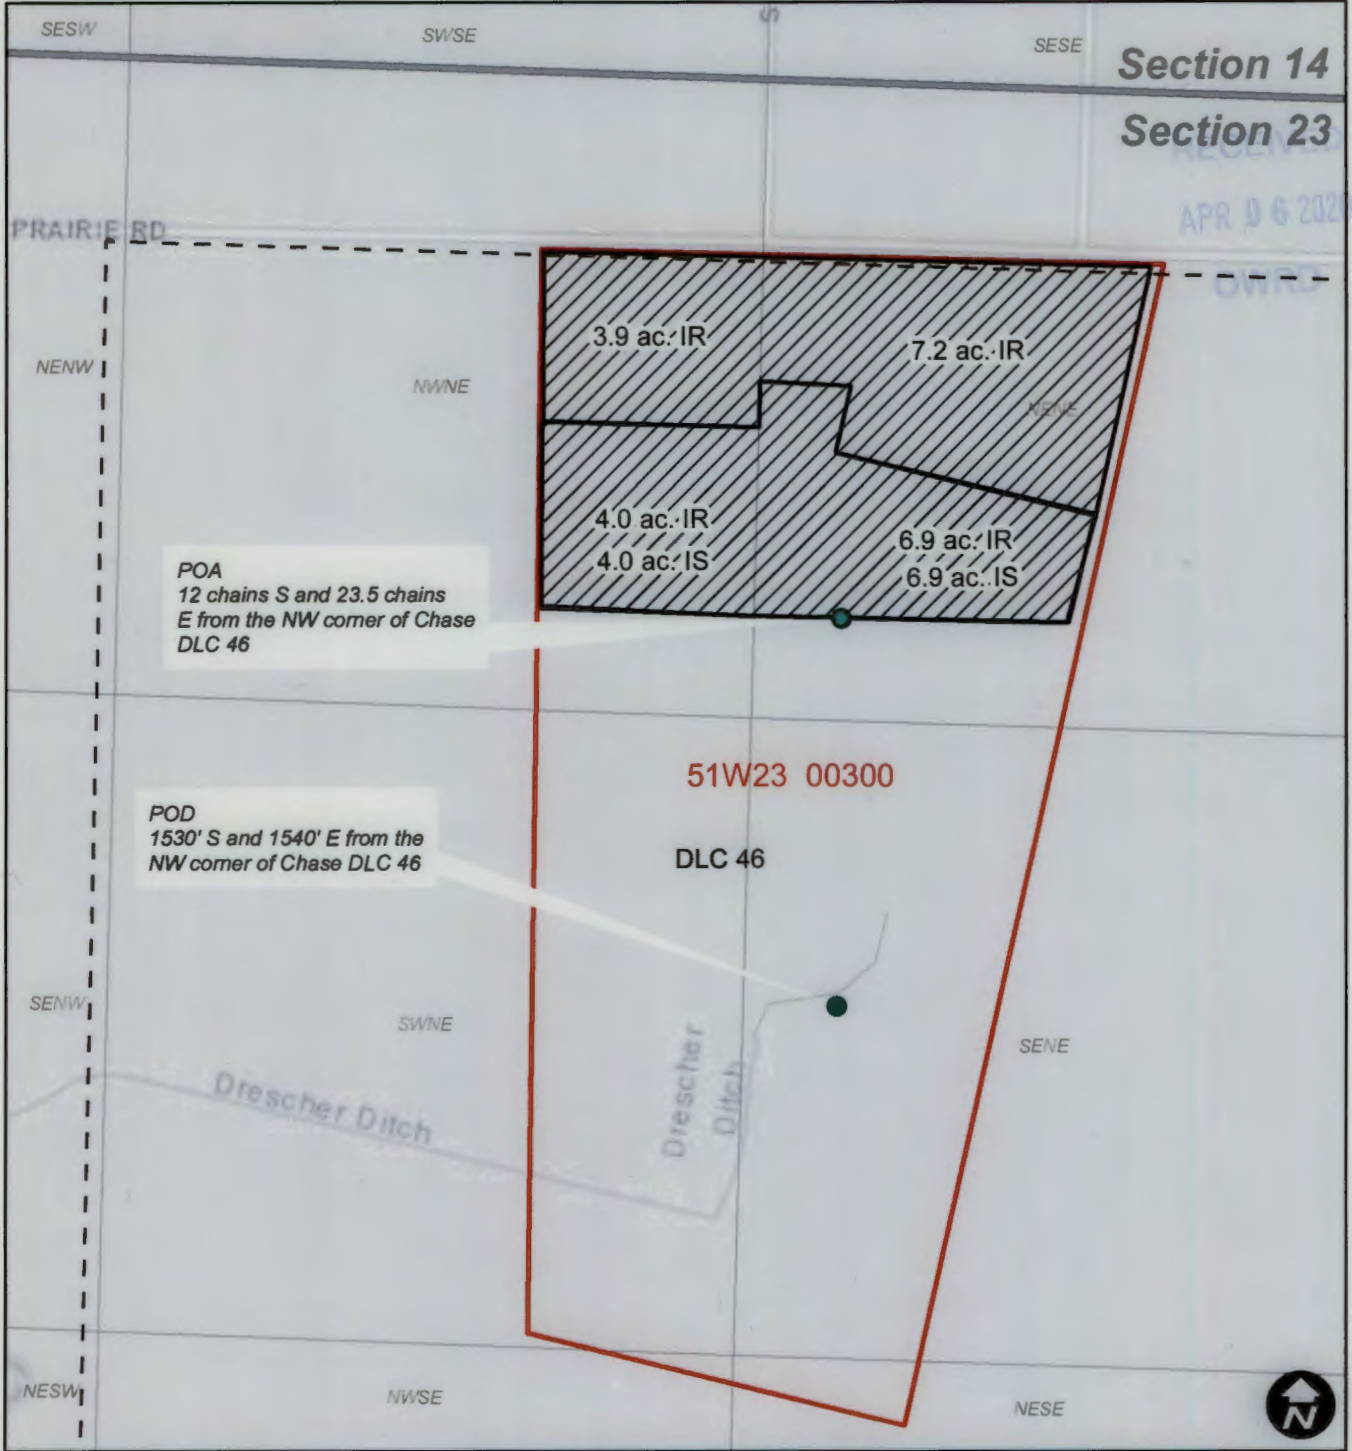


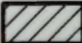
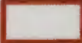
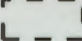
# Transfer Application T-8290

## Claim of Beneficial Use

Township 5S, Range 1W, W.M.



### Legend

-  Place of Use
-  Tax Lot
-  DLC



EXPIRES: 12/31/2020

