


APPLICATION MAP TO APPROPRIATE GROUNDWATER FOR NURSERY USE

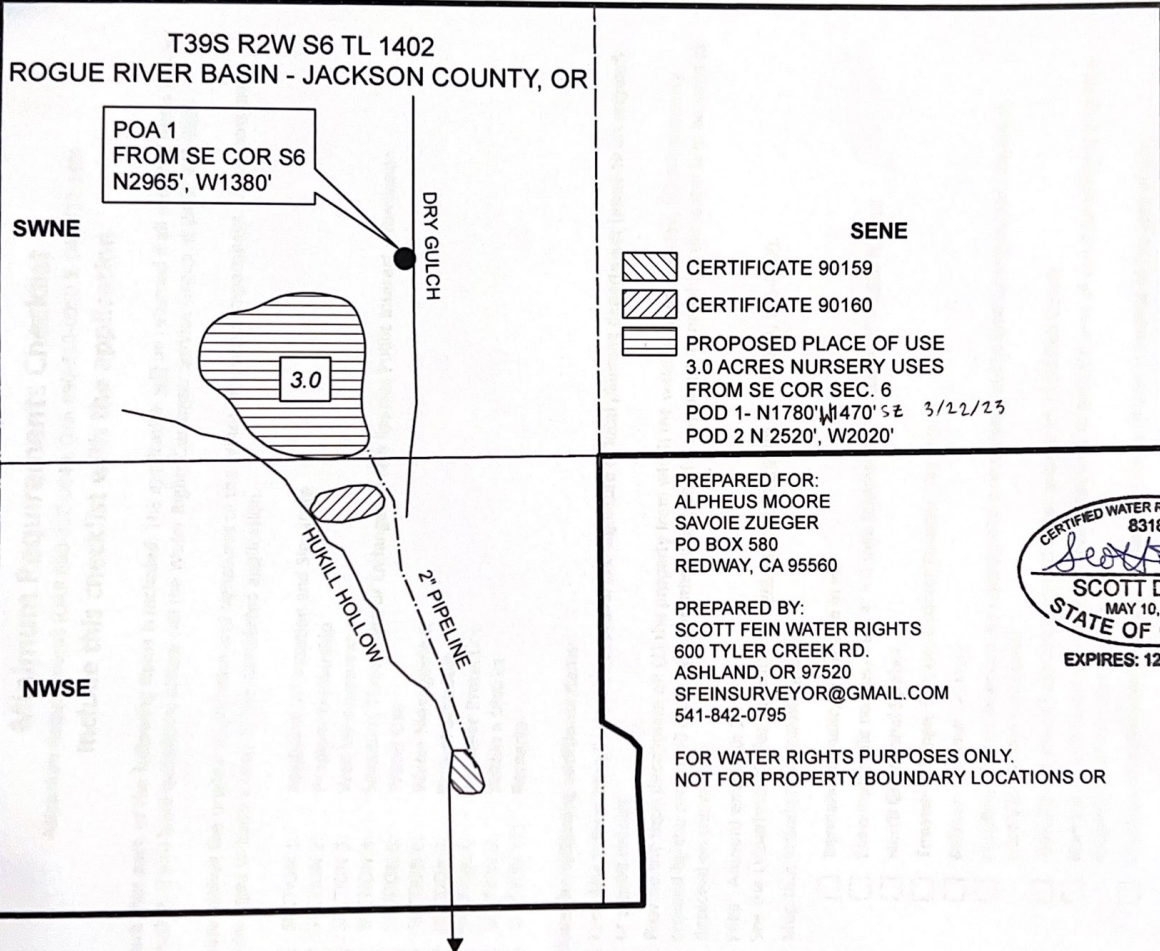

CERTIFIED WATER RIGHT EXAMINER  
83181  
*Scott D. Fein*  
SCOTT D. FEIN  
MAY 10, 2012  
STATE OF OREGON  
EXPIRES: 12/31/2023