



**Claim of Beneficial Use
VFO Independence, LLC
Transfer T-13366
Benton County, Oregon
Township 12 South, Range 5 West (W.M.)**

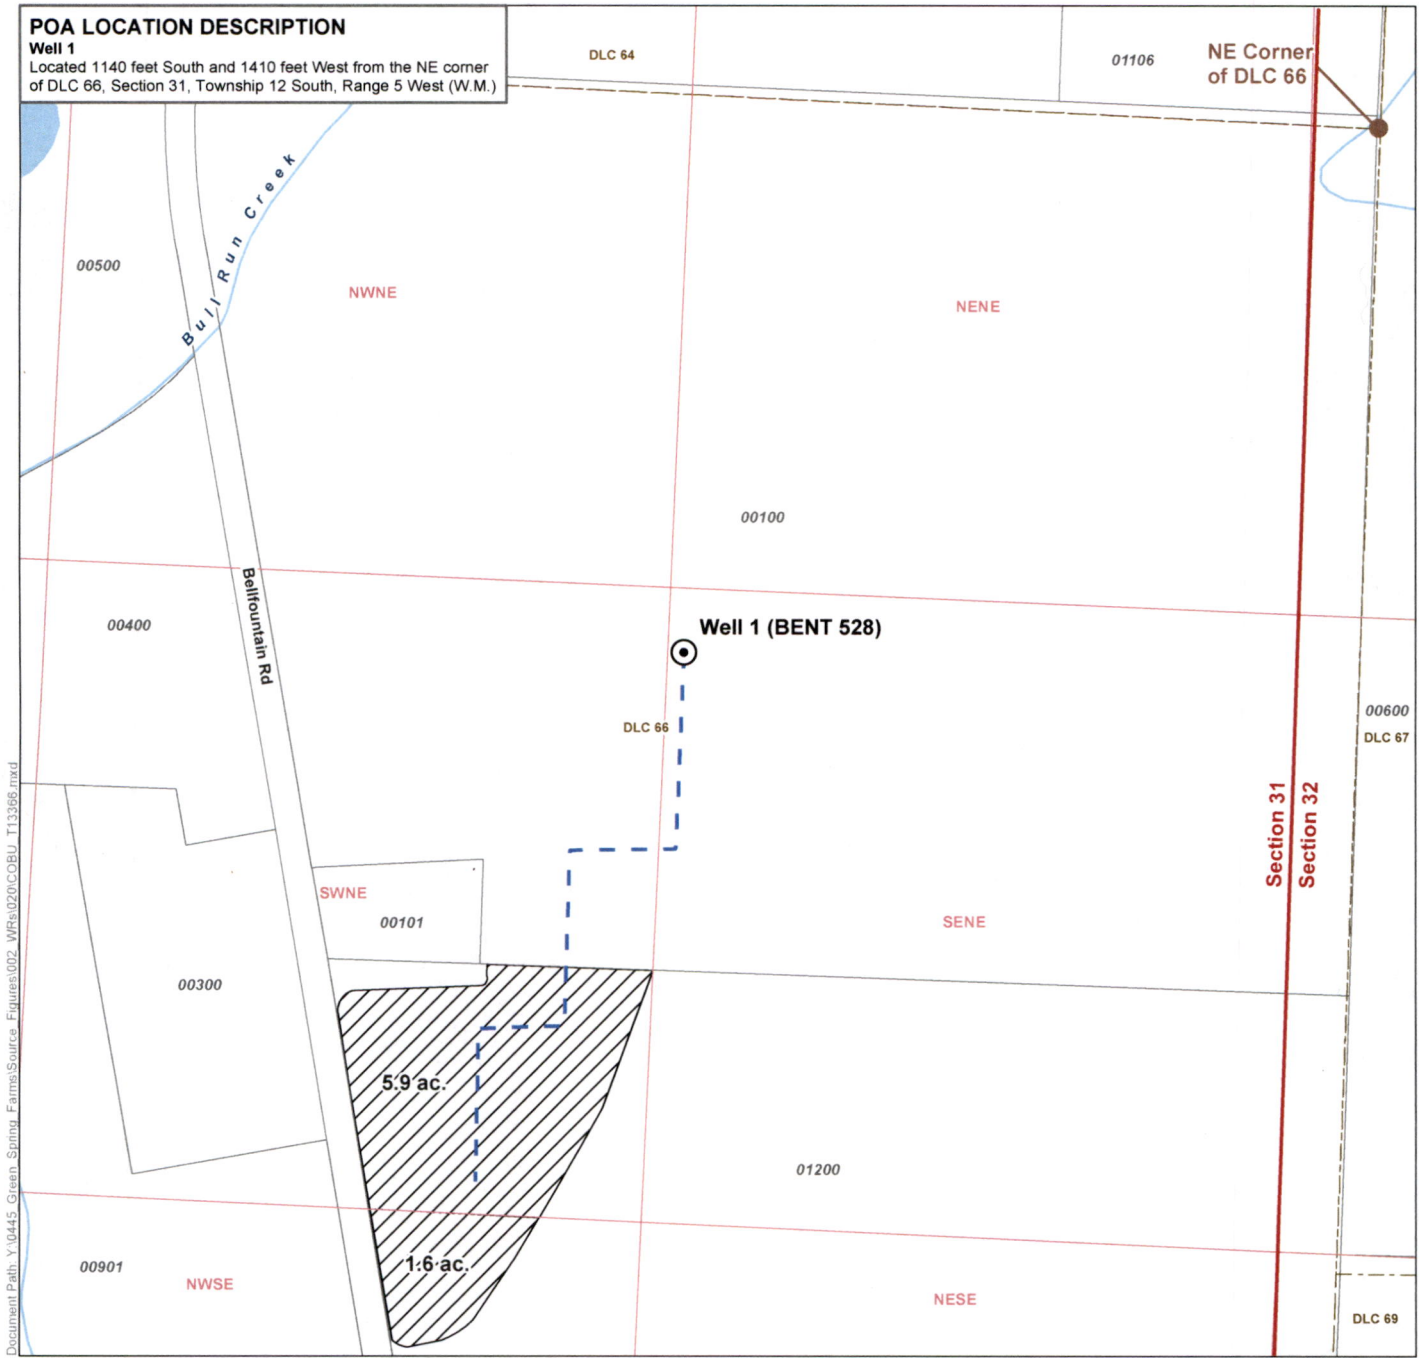

- LEGEND**
- ⊙ Authorized Point of Appropriation (POA)
 - Mainline
 - ▨ Place Of Use (POU)
- All Other Features**
- - - Donation Land Claim (DLC)
 - + Tax Lot
 - ~ Watercourse

Certified Water Rights Examiner Stamp

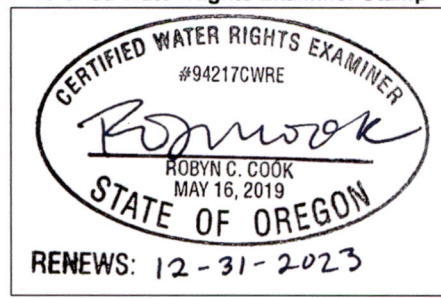

DISCLAIMER
This map was prepared for the purpose of identifying the location of a water right only and it is not intended to provide legal dimensions or location of property ownership lines.

MAP NOTES
Date: April 18, 2023
Data Sources: USGS, BLM, ESRI, Benton Co.

RECEIVED
MAY 12 2023
OWRD
SALEM, OREGON

