

RECEIVED
MAY 18 2023



Oregon Water Resources Department
725 Summer Street NE, Suite A
Salem, Oregon 97301
(503) 986-0900
www.oregon.gov/OWRD

OWRD Ownership Update for Certificated Rights Only

NO FEES ARE REQUIRED TO SUBMIT THIS FORM

NOTICE: A certificate of water right typically stays with the land. To track water right ownership, the Department requests that this form be submitted to the Department. **To update multiple rights, a separate form is required for each right.** If you have any questions about this form, please contact your local watermaster, or call the Water Resources Department at (503) 986-0900.

Note: Use the assignment form to change ownership on pending applications, permits, transfers, groundwater registrations, or limited licenses.

Current Landowner Information							
Name:	Henry Wegermann, as Trustee of the Henry *						
Mailing Address:	5730 N. 1st St., Suite 105-327,						
City:	Fresno	State:	CA	Zip:	93710		
Phone:	559-288-9879	Email:	rgsbrasil@hotmail.com				
*Wegermann Living Trust created May 21, 2014							
Property Information							
County:	Grant	Township:	12	Range:	26	Section:	34
Tax Lot #:	2102						
Street Address of Water Right:	43266 Hwy 26, Dayville, OR 97825						
Water Right Information							
Application:	61684						
Permit:	45797						
Certificate:	60515						
Are all the lands associated with this water right owned by the requestor? <input type="checkbox"/> Yes <input checked="" type="checkbox"/> No							
(If no, include a map showing the portion of the water right involved)							

Signature and Date		
Name of individual completing form:	Henry Wegermann	
Phone or email:	559-288-9879	Date: 5/10/23
Signature of requestor:	<i>Henry Wegermann</i>	

The Department does not change names on water right certificates. This form will be placed in the file for future reference only. If mailed, the Department will not provide acknowledgment of receipt.

This form can be mailed to the address above or sent by email to wrd_dl_customerservice@water.oregon.gov

STATE OF OREGON
COUNTY OF GRANT
CERTIFICATE OF WATER RIGHT

THIS CERTIFICATE ISSUED TO

GARY MOULTON
ROUTE 1, BOX 32
DAYVILLE, OREGON 97825

confirms the right to use the waters of AN UNNAMED SPRING, a tributary of JOHN DAY RIVER, for the purpose of DOMESTIC USE FOR TWO FAMILIES.

The right has been perfected under Permit 45797. The date of priority is MAY 18, 1981. The right is limited to not more than 0.01 CUBIC FOOT PER SECOND or its equivalent in case of rotation, measured at the point of diversion from the source.

The point of diversion is located as follows:

NW 1/4 SE 1/4, SECTION 34, T 12 S, R 26 E, W.M.; 1290 FEET SOUTH AND 640 FEET EAST FROM THE C1/4 CORNER SECTION 34.

The right shall conform to such reasonable rotation system as may be ordered by the proper state officer.

A description of the place of use under the right, and to which such right is appurtenant, is as follows:

*one of the authorized
domestics appear
to fall on Tax lot 2103
of T. 12S R. 26E W.M.
8-22-16*

→ SE 1/4 NE 1/4
SECTION 34
TOWNSHIP 12 SOUTH, RANGE 26 EAST, W.M.

The right to the use of the water for the above purpose is restricted to beneficial use on the lands or place of use described. The right is subject to minimum flows established by the Water Resources Commission with an effective date prior to this right.

WITNESS the signature of the Water Resources Director, affixed this date MARCH 23, 1989.

WILLIAM W. YOUNG
Water Resources Director

Recorded in State Record of Water Right Certificates numbered 60515

61684.TMW

RECEIVED

MAY 18 2023


OWRD

P-45797

C-60515

T. 12 S., R. 26 E., W.M.

N

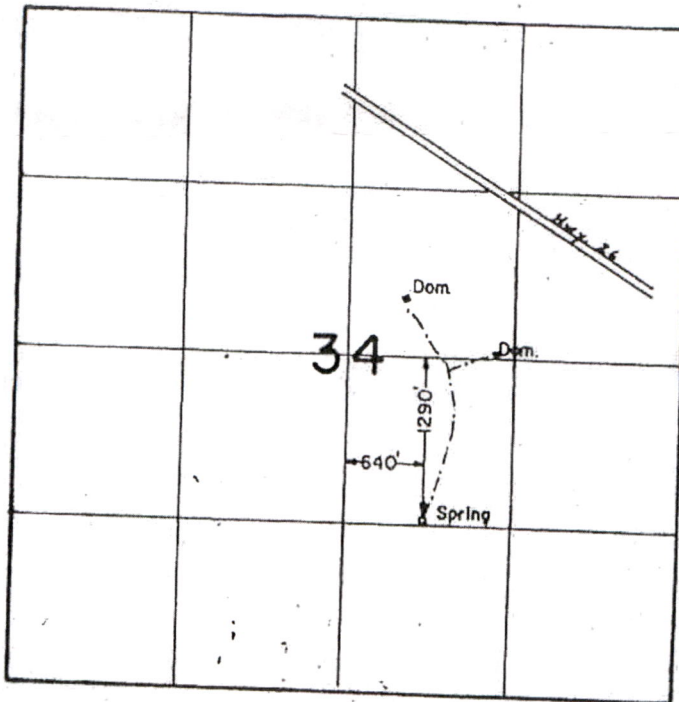

Scale: 1" = 1320'

FINAL PROOF SURVEY
UNDER

Application No. 61684 Permit No. 45797
IN NAME OF

GARY MOULTON

Surveyed JUNE 18 1988, by T. Warren


THIS MAP WAS PREPARED FOR
ASSESSMENT PURPOSE ONLY



T.12S. R.26E. W.M.
GRANT COUNTY

12S26E

WHEELER COUNTY

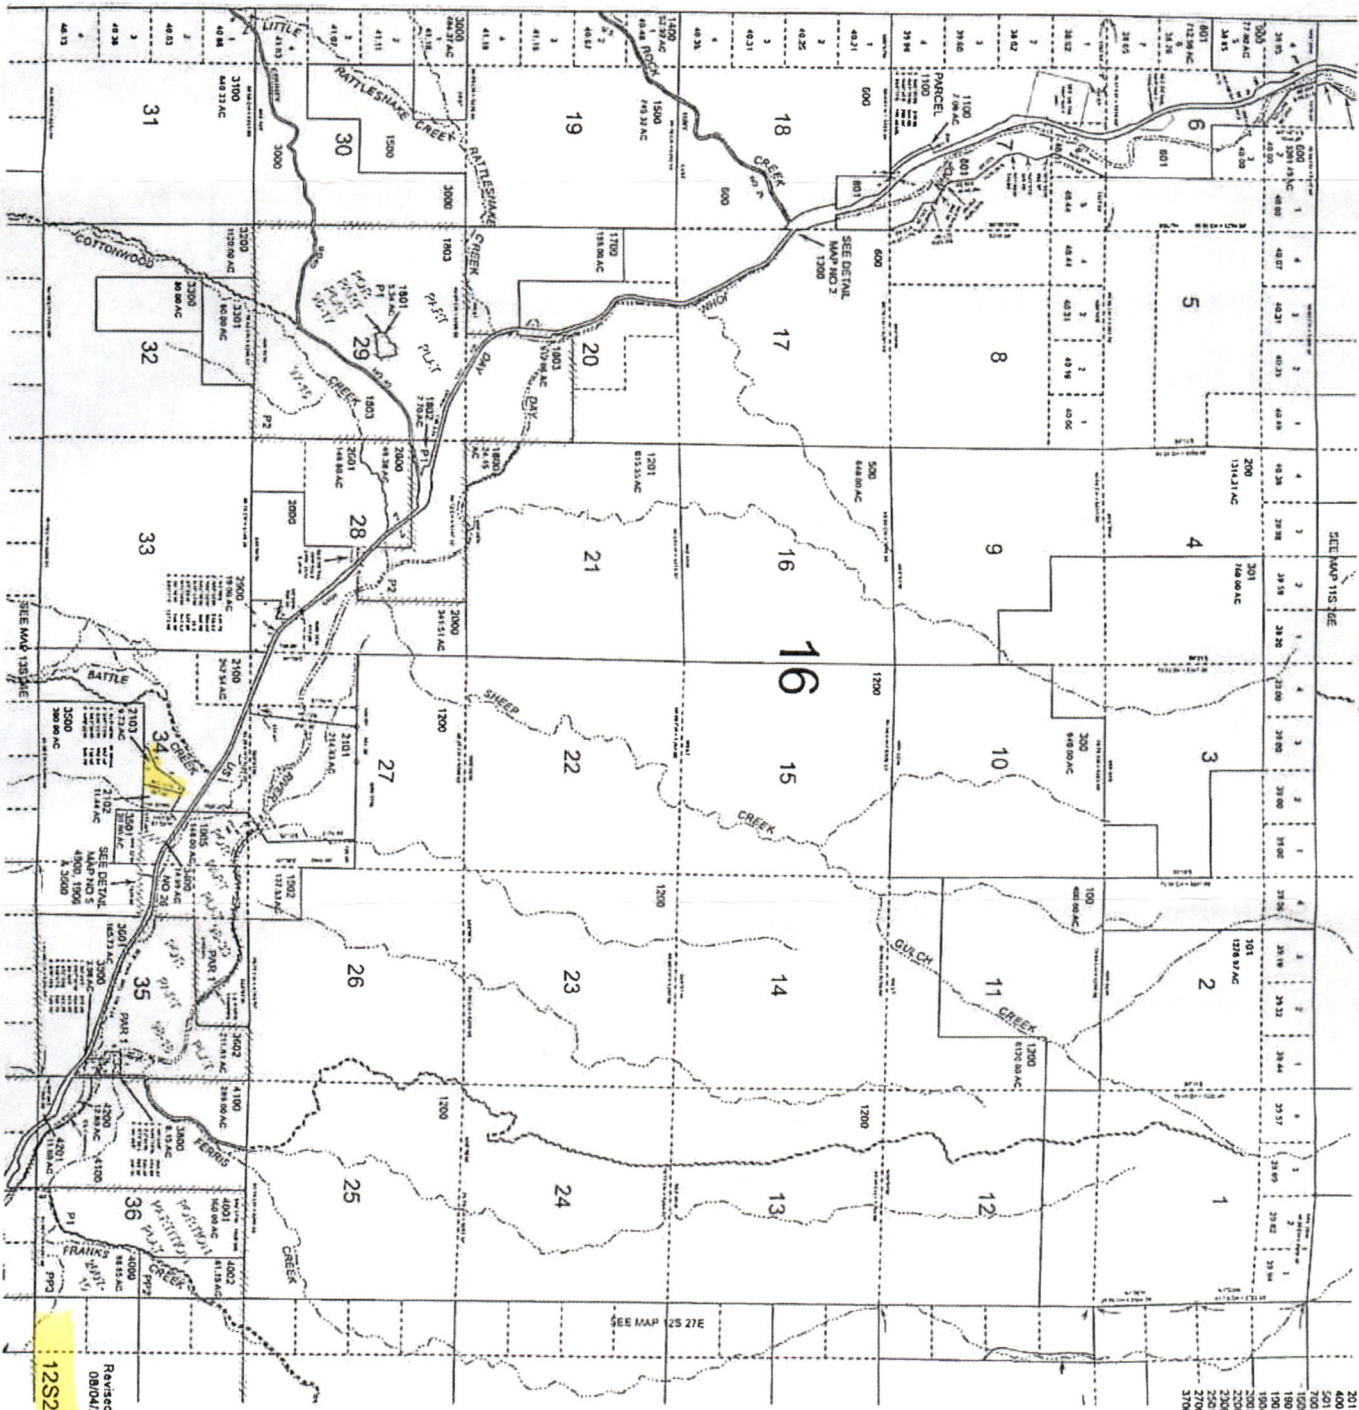

Cancelled
201
200

OWRD

MAY 18 2023

RECEIVED

Revised: SH
08/04/2014
12S26E