


TOWNSHIP 19 SOUTH, RANGE 12 WEST, W.M.

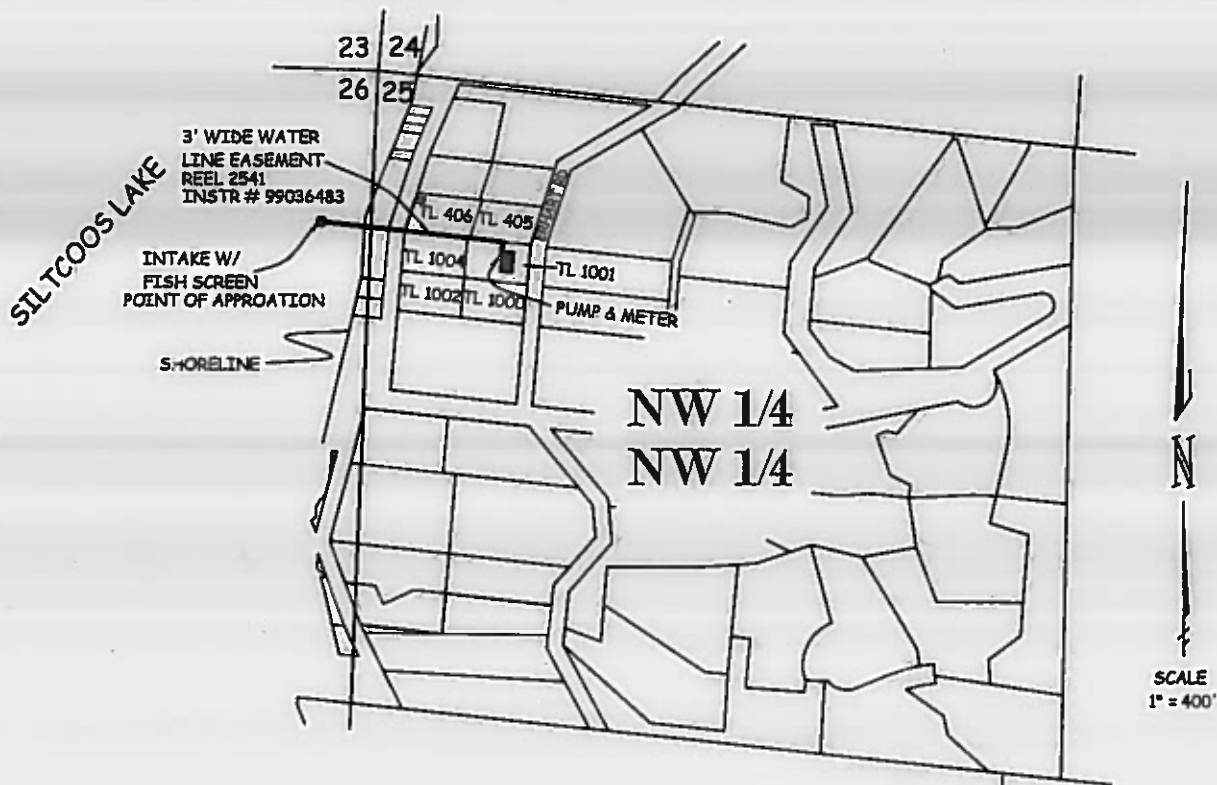

APPLICATION S-86940/T-12697.cao

PERMIT S-55140

**LEGEND**


- DENOTES HOUSE LOCATION
- DENOTES POINT OF APPROPRIATION LOCATION
- DENOTES POINT OF APPROPRIATION LOCATION

SEE TAX MAP NO. 19-12-25-22 FOR TAX LOT INFO.

THIS MAP WAS PREPARED FOR THE PURPOSE OF IDENTIFYING THE LOCATION OF THE WATER RIGHT ONLY. IT IS NOT INTENDED TO PROVIDE DIMENSIONS OR LOCATION OF PROPERTY OWNERSHIP LINES.

**FINAL PROOF SURVEY  
FOR  
JUDITH DAHLBERG  
83396 ERHART ROAD  
FLORENCE, OR 97439**

**BY  
H. TIMOTHY FASSBENDER, PLS, CWRE  
2896 SARAH LANE  
EUGENE, OR. 97408  
AUGUST 20, 2019**

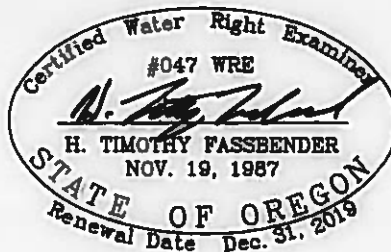

RECEIVED  
SEP 05 2019  
OWRD