


Scale: 1" = 800'

Revised Map

RECEIVED
APR 04 2023
OWRD

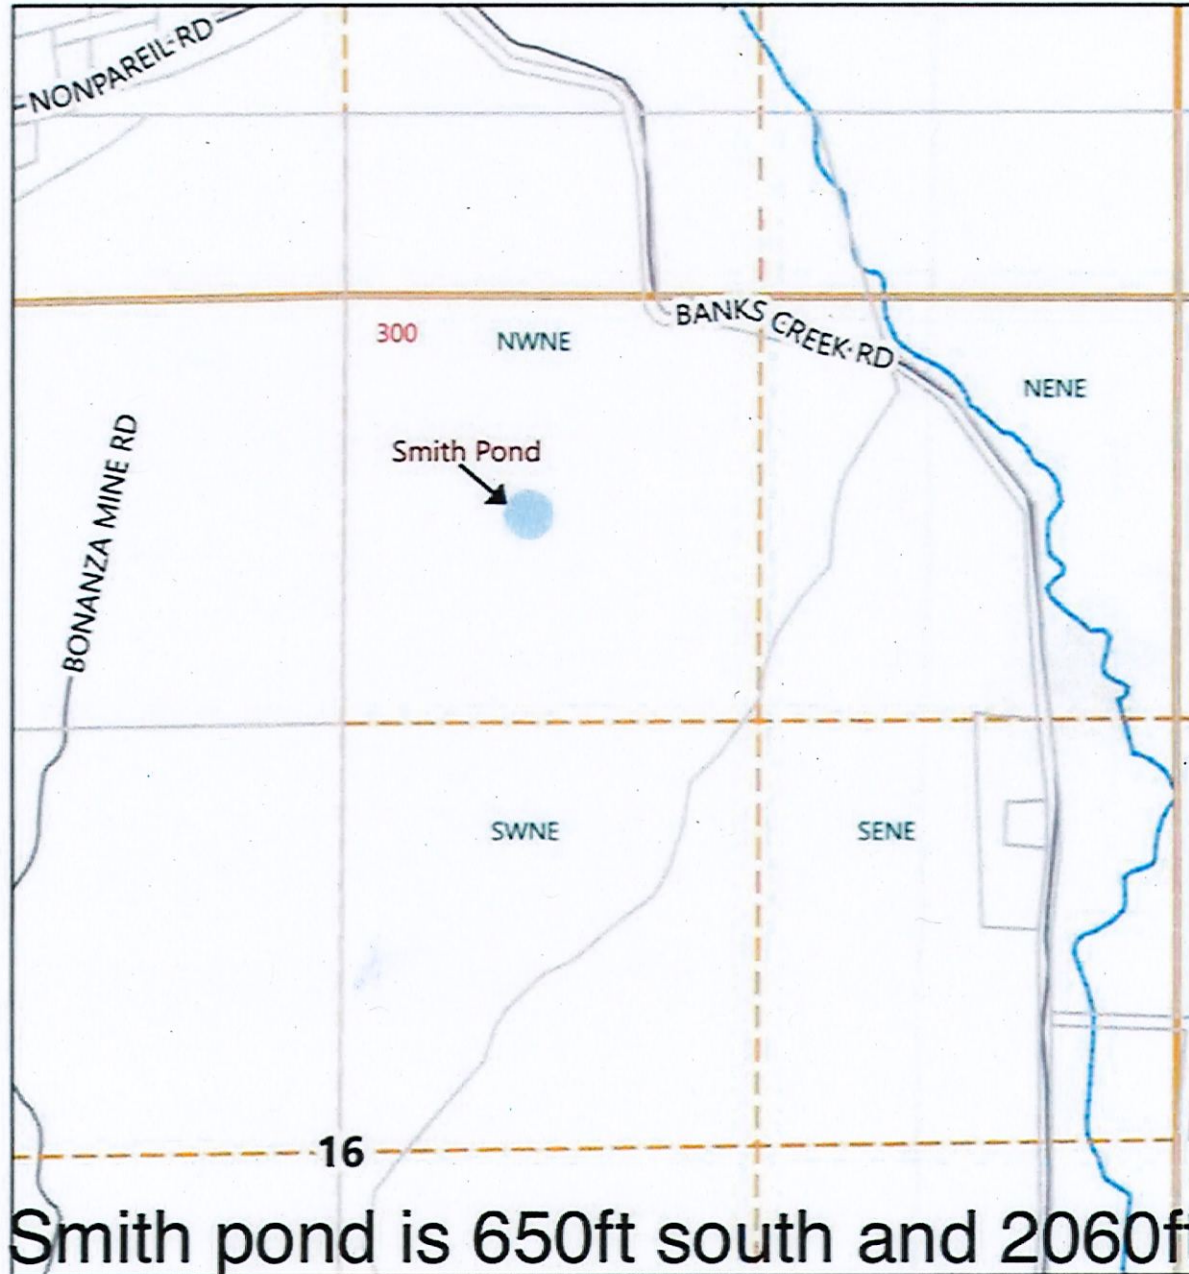

Smith pond is 650ft south and 2060ft west from the NE section corner 16