


BECK and SIBBERNSEN  
1200 STERLING CREEK ROD  
JACKSONVILLE, OR 97530

CLAIM OF BENEIFICAL USE  
RESERVOIR STORAGE RIGHT

PERMIT R-15313  
APPLICATION R-88487  
SITUATED IN  
SECTION 7, TOWNSHIP 38 S RANGE 2 W, W.M.  
JACKSON COUNTY OREGON

RECEIVED  
MAY 25 2023  
OWRD

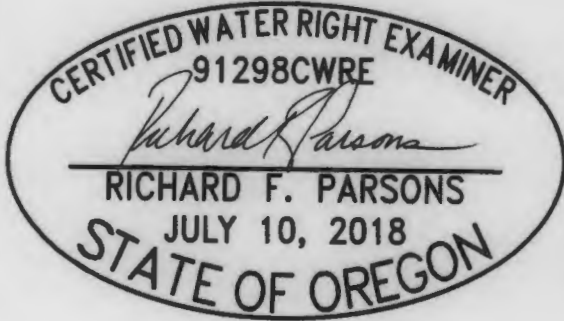

LEGEND

- DAM
- ▲ 125' NORTH and 385' EAST OF WEST 1/4 CORNER SECTION 7, T38S R2W
- POORMAN CREEK POD and PUMP  
20' NORTH and 395' EAST OF WEST 1/4 CORNER SECTION 7, T38S R2W
- PIPELINE

