


QT/QT=SWSW

MAP TAX LOT: 35S, 06W, 05-00-001300-00

LAT/LONG: 42.550349, -123.445026


3434 QUARTZ CREEK RD. MERLIN OR 97532

266.4 FEET NORTH AND 108.4 FEET EAST FROM THE SW CORNER OF SECTION 5

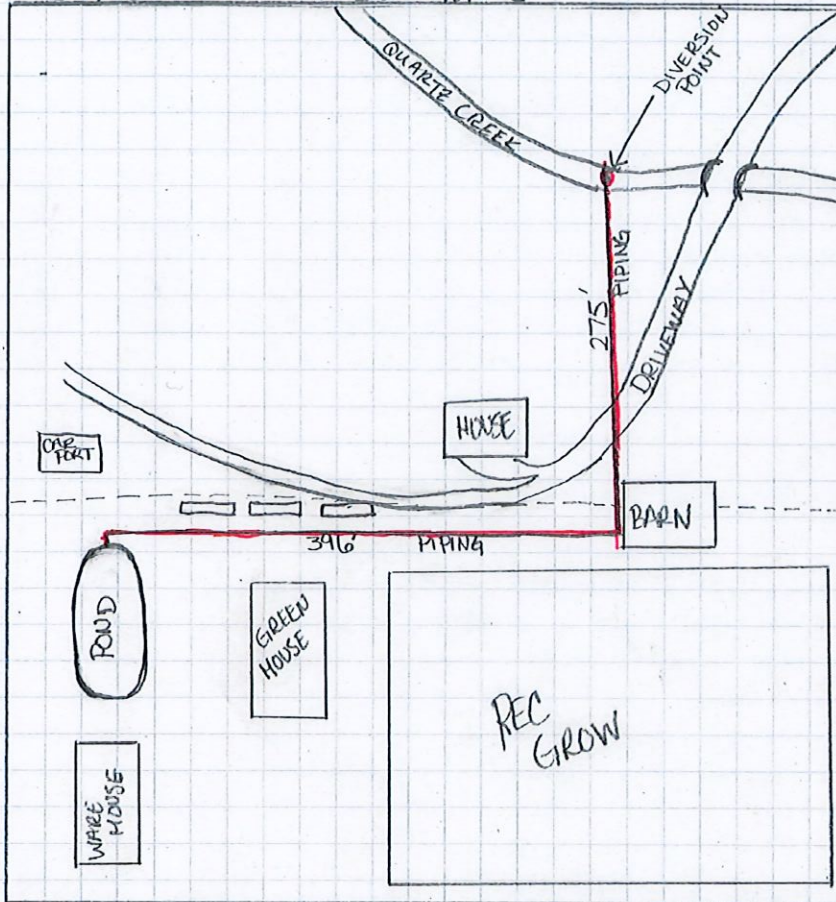

RECEIVED
APR 06 2023
OWRD

POND CAPACITY:
.918 AF

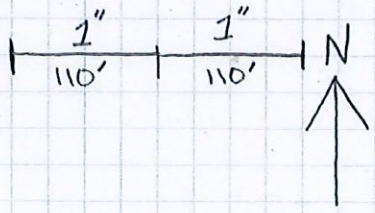

DIVERSION LOCATION FROM LAND SURVEY CORNER

490 FEET NORTH AND 568 FEET EAST FROM THE SW CORNER OF THE
SOUTHWEST QUARTER OF THE SOUTHWEST QUARTER OF SECTION 5, TOWNSHIP
35 SOUTH, RANGE 6 WEST OF THE WILLAMETTE MERIDIAN, JOSEPHINE COUNTY,
OREGON.

LATITUDE AND LONGITUDE:

42.551086, -123.4435

POND LOCATION FROM LAND SURVEY CORNER

266.4 FEET NORTH AND 108.4 FEET EAST FROM THE SW CORNER OF THE
SOUTHWEST QUARTER OF THE SOUTHWEST QUARTER OF SECTION 5, TOWNSHIP
35 SOUTH, RANGE 6 WEST OF THE WILLAMETTE MERIDIAN, JOSEPHINE COUNTY,
OREGON.

LATITUDE AND LONGITUDE TO CENTER OF POND:

42.550349, -123.445026

RECEIVED

APR 06 2023

OWRD