


RECEIVED

JUN 02 2023

Claim of Beneficial Use - Grewal Transfer T-10515

OWRD

Township 2S, Range 3E, W.M.

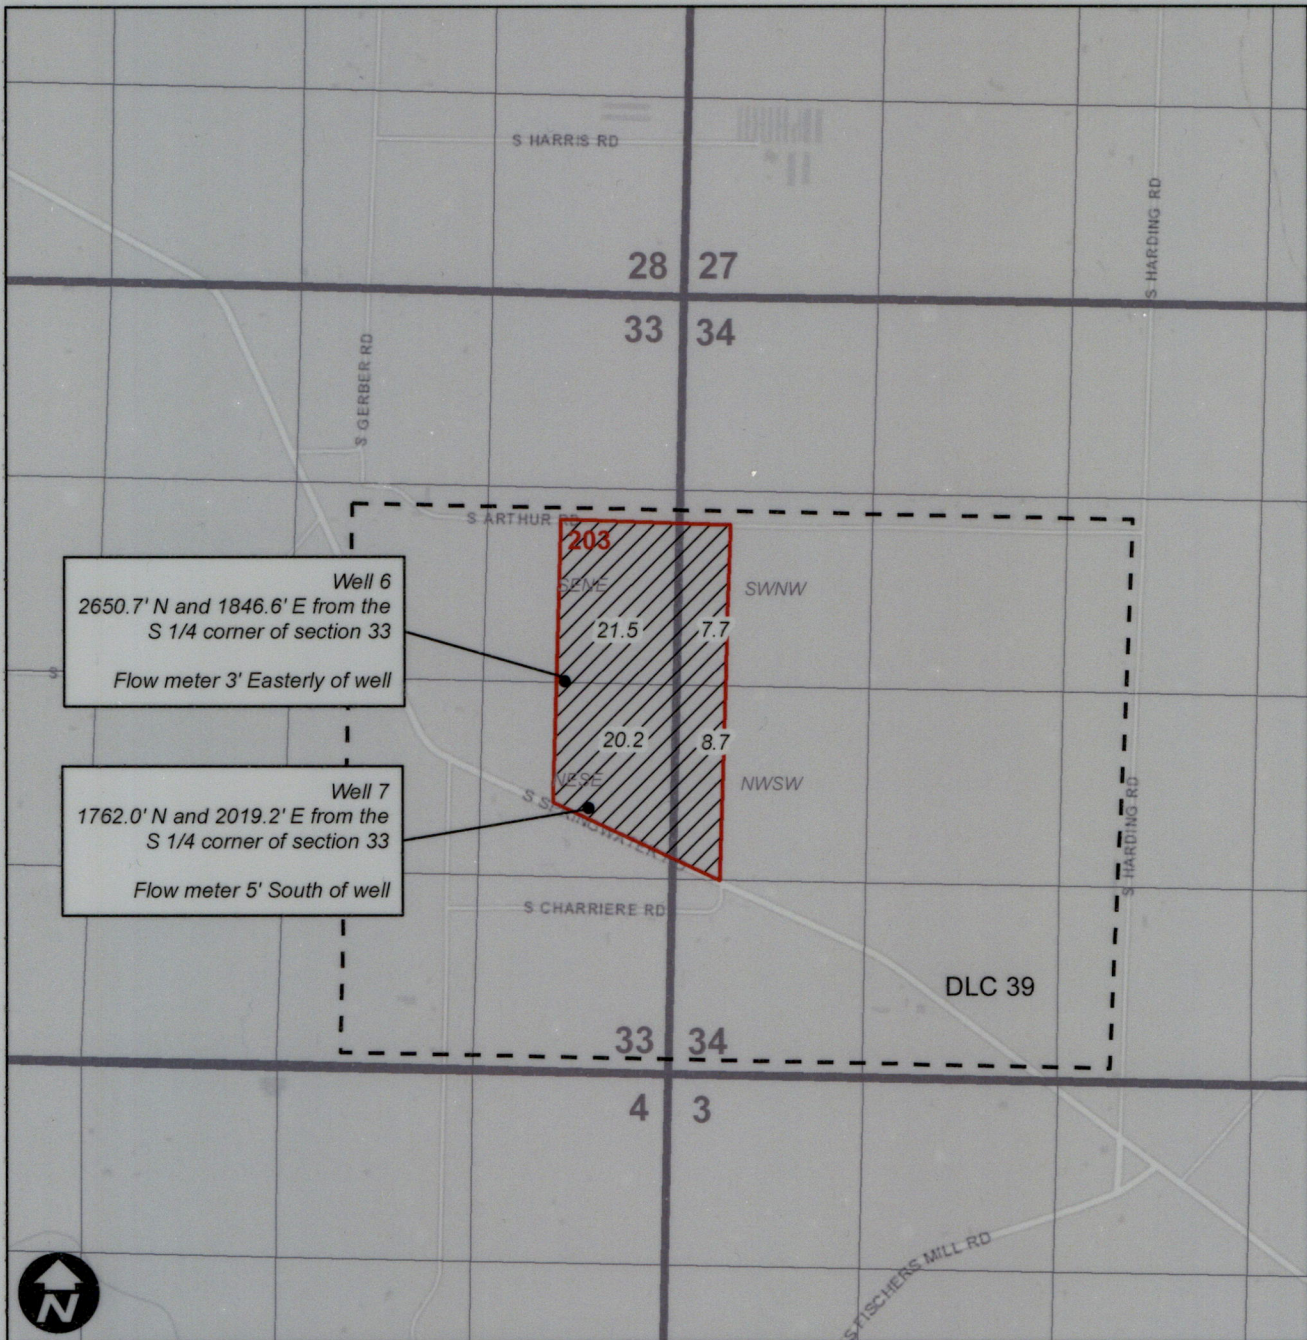

This map is not intended to provide legal dimensions or locations of property ownership lines.

0 660 1,320 2,640 Feet

Legend

POU Tax Lot DLC

