



United States Department of the Interior



BUREAU OF RECLAMATION
1150 North Curtis Road
Boise, ID 83706-1234

IN REPLY REFER TO:

CPN-6323
2.2.4.23

JUN 1 2 2023

Mr. James Orosz
Ms. Janette Hildebrand
2866 Dusty Stone CT
Santa Rosa, CA 95405

Subject: Successor in Interest to Water Service Contract No. 219E102102, Applegate Reservoir, Rogue River Basin Project, Oregon

Dear Mr. Orosz and Ms. Hildebrand:

Enclosed for your records is an executed successor in interest document that recognizes you as the successors in interest to Contract No. 219E102102, dated July 28, 2021. If you have questions, please contact Ms. Joy Kelley, Repayment Specialist, at the above address, at (986) 999-8984, jkelly@usbr.gov, or me at (208) 378-5306 or emcgarry@usbr.gov. If you are deaf, hard of hearing, or have a speech disability, please dial 7-1-1 to access telecommunications relay services.

Sincerely,

E. Gail McGarry
Program Manager
Reclamation Law Administration

Enclosure

cc: Water Rights Division
Oregon Water Resources Department
725 Summer Street NE, Suite A
Salem, OR 97301-1271
(w/ copy of encl to each)

U.S. Army Corps of Engineers
Attention: CENWP-EC-HR
P.O. Box 2946
Portland, OR 97208-2946

INTERIOR REGION 9 • COLUMBIA-PACIFIC NORTHWEST

IDAHO, MONTANA*, OREGON*, WASHINGTON


* PARTIAL

RECOGNITION OF SUCCESSOR IN INTEREST TO ROGUE RIVER BASIN
PROJECT WATER SERVICE CONTRACT NO. 219E102102

WHEREAS, the United States of America entered into a contract on July 28, 2021, Contract No. 219E102102, with David and Katherine Maguire for an irrigation water supply from Applegate Reservoir for use on lands owned by the Contractor; and

WHEREAS, the subject land has been conveyed to James Orosz and Janette Hildebrand and they request that they be recognized as the successors in interest to this contract at 14738 Upper Applegate Road, Jacksonville, OR 87530, (mailing address: 2866 Dusty Stone Ct, Santa Rosa, CA, 95405);


NOW, THEREFORE, all right, title and property interest in Contract No. 219E102102, dated July 28, 2021, for an irrigation water supply not to exceed 4 acre-feet annually and limited to the place of use on 3.3 acres provided on the attached map, Exhibit A, are hereby recognized to be held by James Orosz and Janette Hildebrand. This contract action is effective only upon the approval by the United States of America as provided in General Provisions, Article 18 (d) of said July 28, 2021.



James Orosz

5/25/23

Date




Janette Hildebrand

5/25/23

Date

The above contract action is hereby approved:

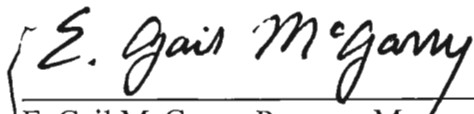

E. Gail McGarry, Program Manager
Reclamation Law Administration
Bureau of Reclamation

June 12, 2023

Date




STATE OF Oregon

County of Jackson

On this 25th day of May, 2023, before me, a notary public, personally appeared James Orosz and Janette Hildebrand, known to me to be the persons whose names are subscribed to the foregoing instrument and acknowledged that they are the legal owners of the property for which a water supply is to be provided under the contract and has executed this contract as their free and voluntary act and deed.

IN WITNESS WHEREOF, I have hereunto set my hand and affixed my official seal as of the day and year first above written.

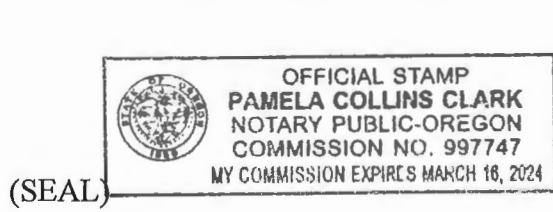


Pamela Collins Clark
Notary Public in and for the
State of Oregon
Residing at: 711 Medford Center, Medford, OR
My commission expires: 03/16/2024 97504

STATE OF IDAHO

County of Ada

On this 14th day of JUNE, 2023, personally appeared before me E. Gail McGarry, known to me to be the official of the UNITED STATES OF AMERICA that executed the within and foregoing instrument, and has acknowledged said instrument to be the free and voluntary act and deed of said United States, for the uses and purposes therein mentioned, and on oath stated that she was authorized to execute said instrument.


IN WITNESS WHEREOF, I have hereunto set my hand and affixed my official seal as of the day and year first above written.

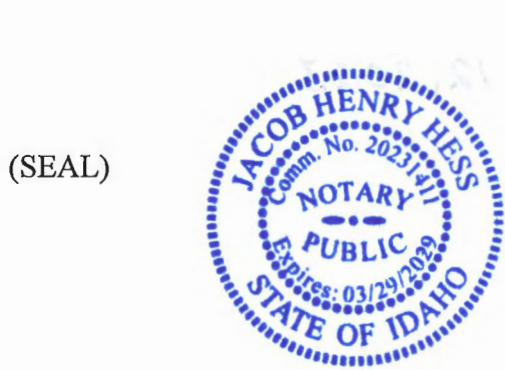

Jacob Hess
Notary Public in and for the
State of IDAHO
Residing at: 512 W. Morris Hill Rd, Apt. 101, Boise, ID, 83706
My commission expires: 03-29-2029

Application No. 62144
Permit No. 46361

T. 40 S. R. 3 W. W. M.

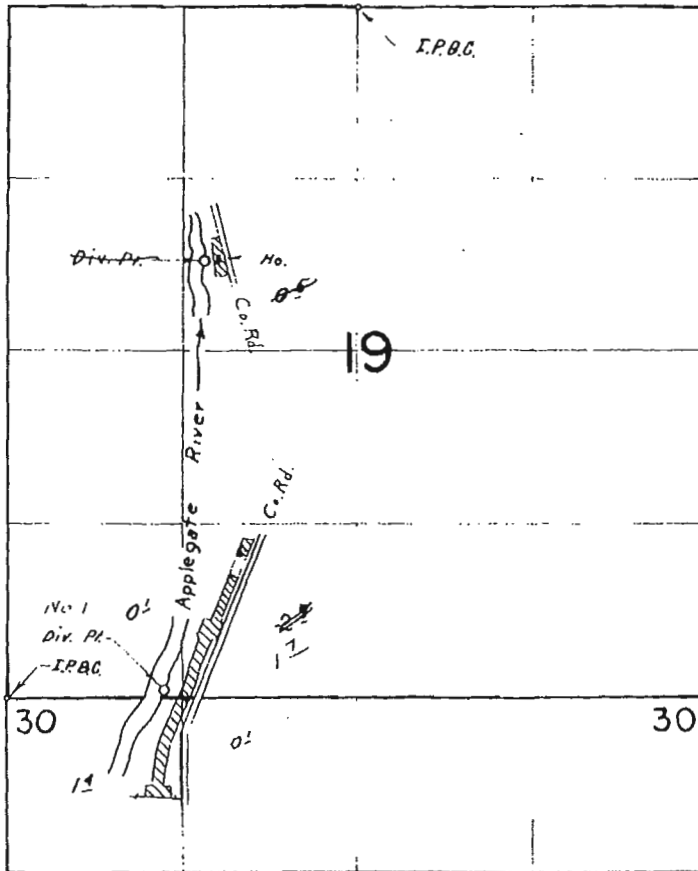

RECEIVED
AUG 6 1981
WATER RESOURCES DEPT.
SALEM, OREGON

Richard Leever
11/23/81

DIV. PTs. LOC.: DIV. NO. 1—50' N & 1190' E FROM SW COR. SEC. 19
DIV. NO. 2—1940' S & 1160' W FROM N 1/4 COR. SEC. 19

Map to accompany application of Martin and/or Linda Heitkamp and Richard and/or Rose Leever to appropriate 4 acre feet of water from Applegate Lake Reservoir to supplementally irrigate 3.30 acres as shown shaded in yellow above.

FINAL PROOF SURVEY
UNDER

Application No. 37843 Permit No. 28212
IN NAME OF

MRS. GERTRUDE HEITKAMP

Surveyed SEP. 17, 1971, by L. E. Gould