

CLAIM of BENEFICIAL USE MAP


FOR: THOMAS (JUSTIN) LINDBLOOM
 BY: NATHAN REED, PE, CWRE
 T27S, R6W, W.M. SECTION 6
 APPLICATION NO. S-88434
 PERMIT NO. S-55095



SCALE: 1" = 1320'

DATE OF SURVEY: MAY 20, 2023

SCALE: 1" = 400'

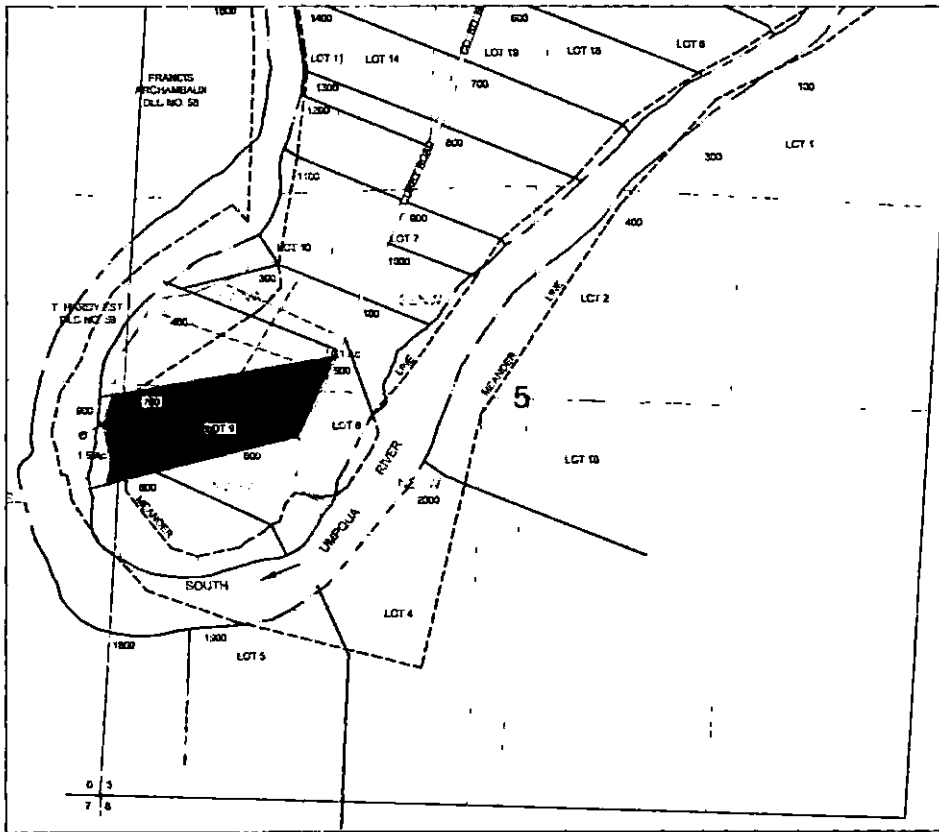


RECEIVED
 JUN 15 2023
 OWRD

POD IS LOCATED 2230 FEET NORTH & 270 FEET WEST OF SE CORNER OF SECTION 6.

MAP PREPARED FOR:
 THOMAS (JUSTIN) LINDBLOOM
 314 BURKHART RAPIDS RD
 ROSEBURG, OR 97471

LEGEND

- WATER
- POD
- ▲ PUMP
- Ⓜ METER
- PIPE
- QUARTER
- SIXTEENTH
- GLOT
- PARCEL
- IRRIGATION

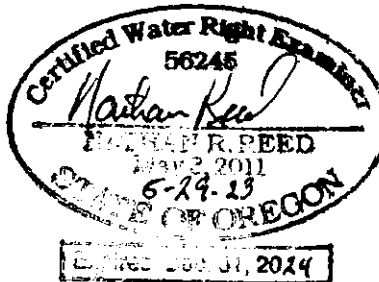

MAP PREPARED BY:
 NATHAN REED PE, CWRE
 157 WEST BODIE STREET
 ROSEBURG, OR 97471

THE PURPOSE OF THIS MAP IS TO IDENTIFY THE LOCATION OF THE WATER RIGHT. IT IS NOT INTENDED TO PROVIDE INFORMATION RELATIVE TO THE LOCATION OF PROPERTY OWNERSHIP BOUNDARY LINES.