


# Groundwater Application - Paratore

Township 8S, Range 4W, Section 33, W.M.

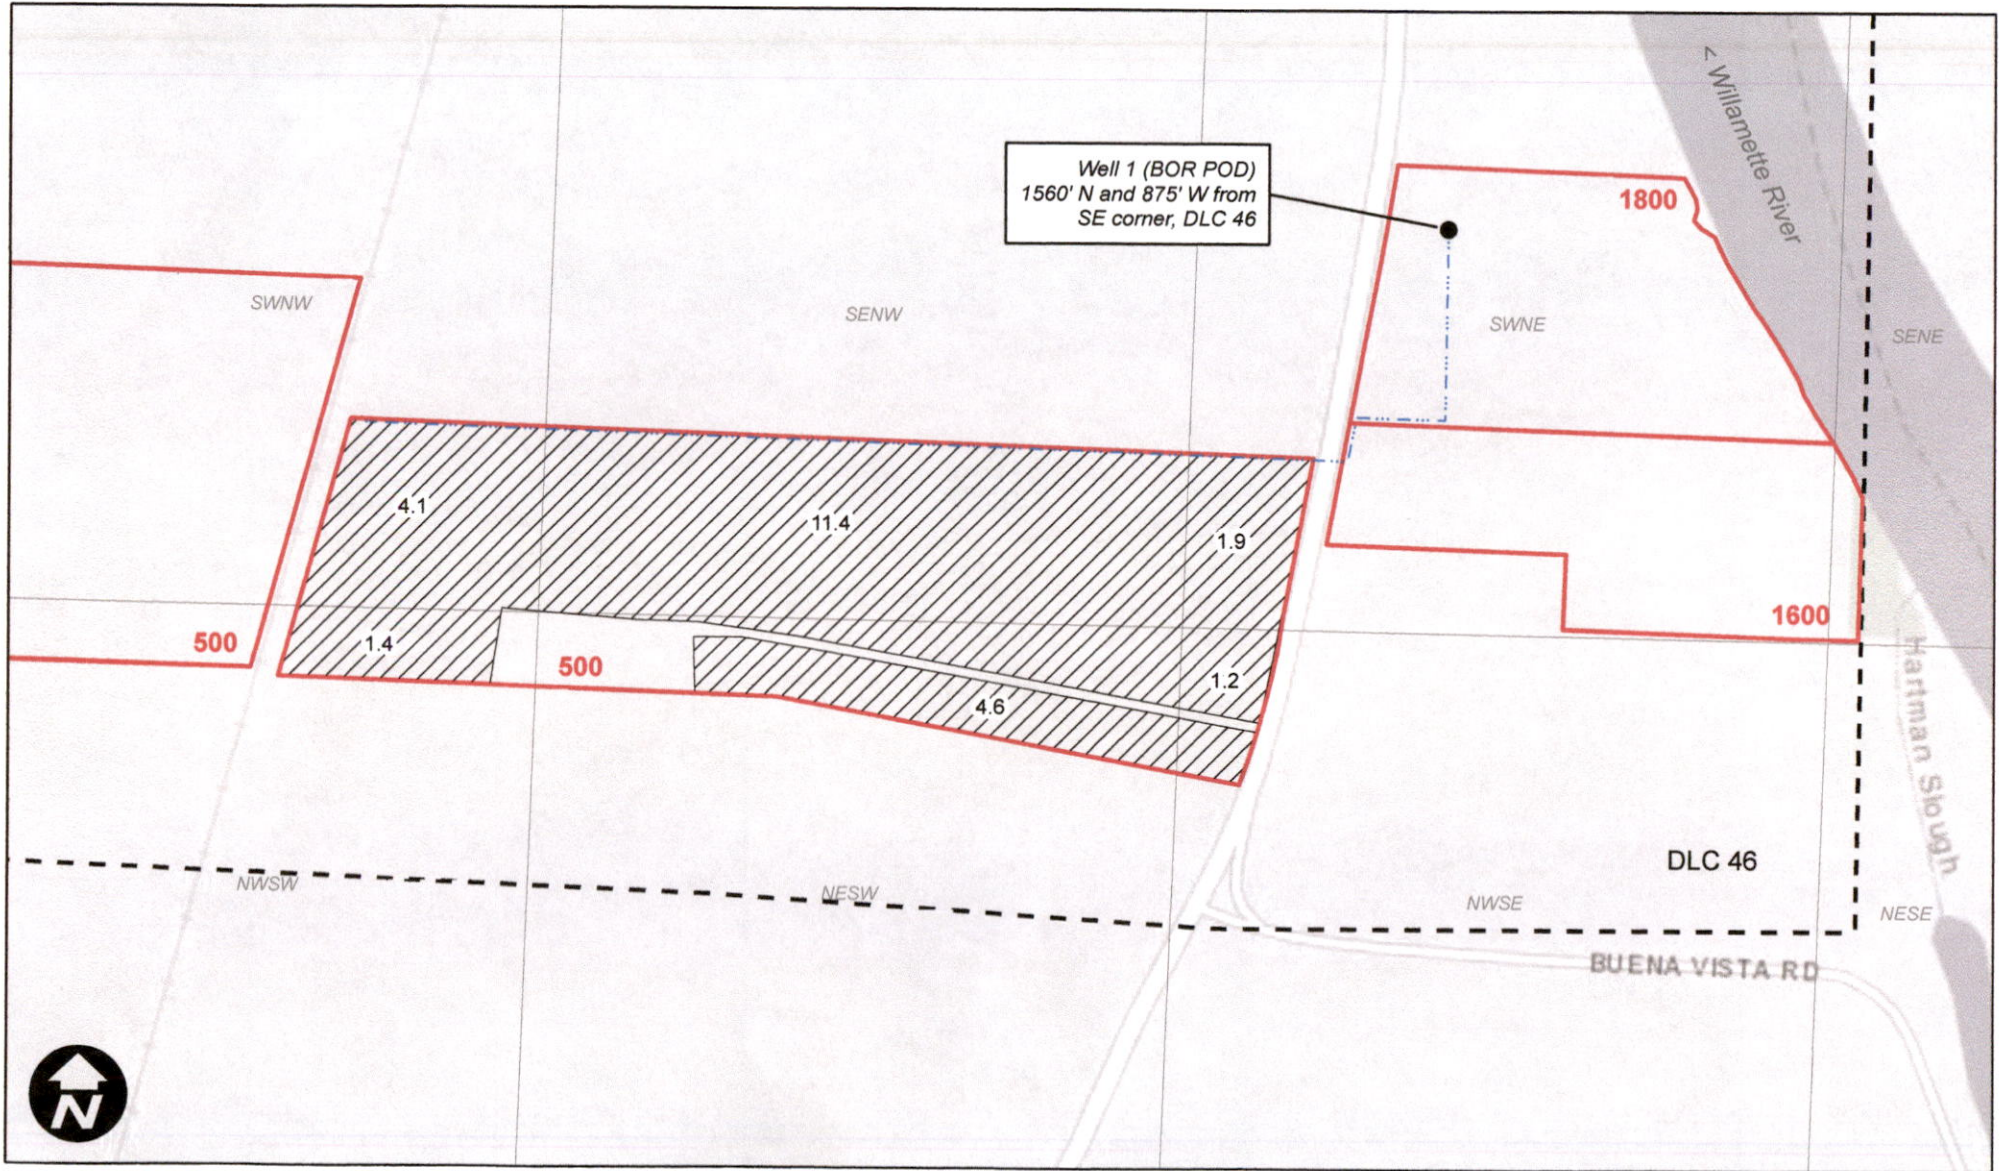

Well 1 (BOR POD)  
1560' N and 875' W from  
SE corner, DLC 46

## Legend

- POU
- Mainline
- Tax Lot
- DLC

RECEIVED  
JUN 15 2023  
OWRD

