


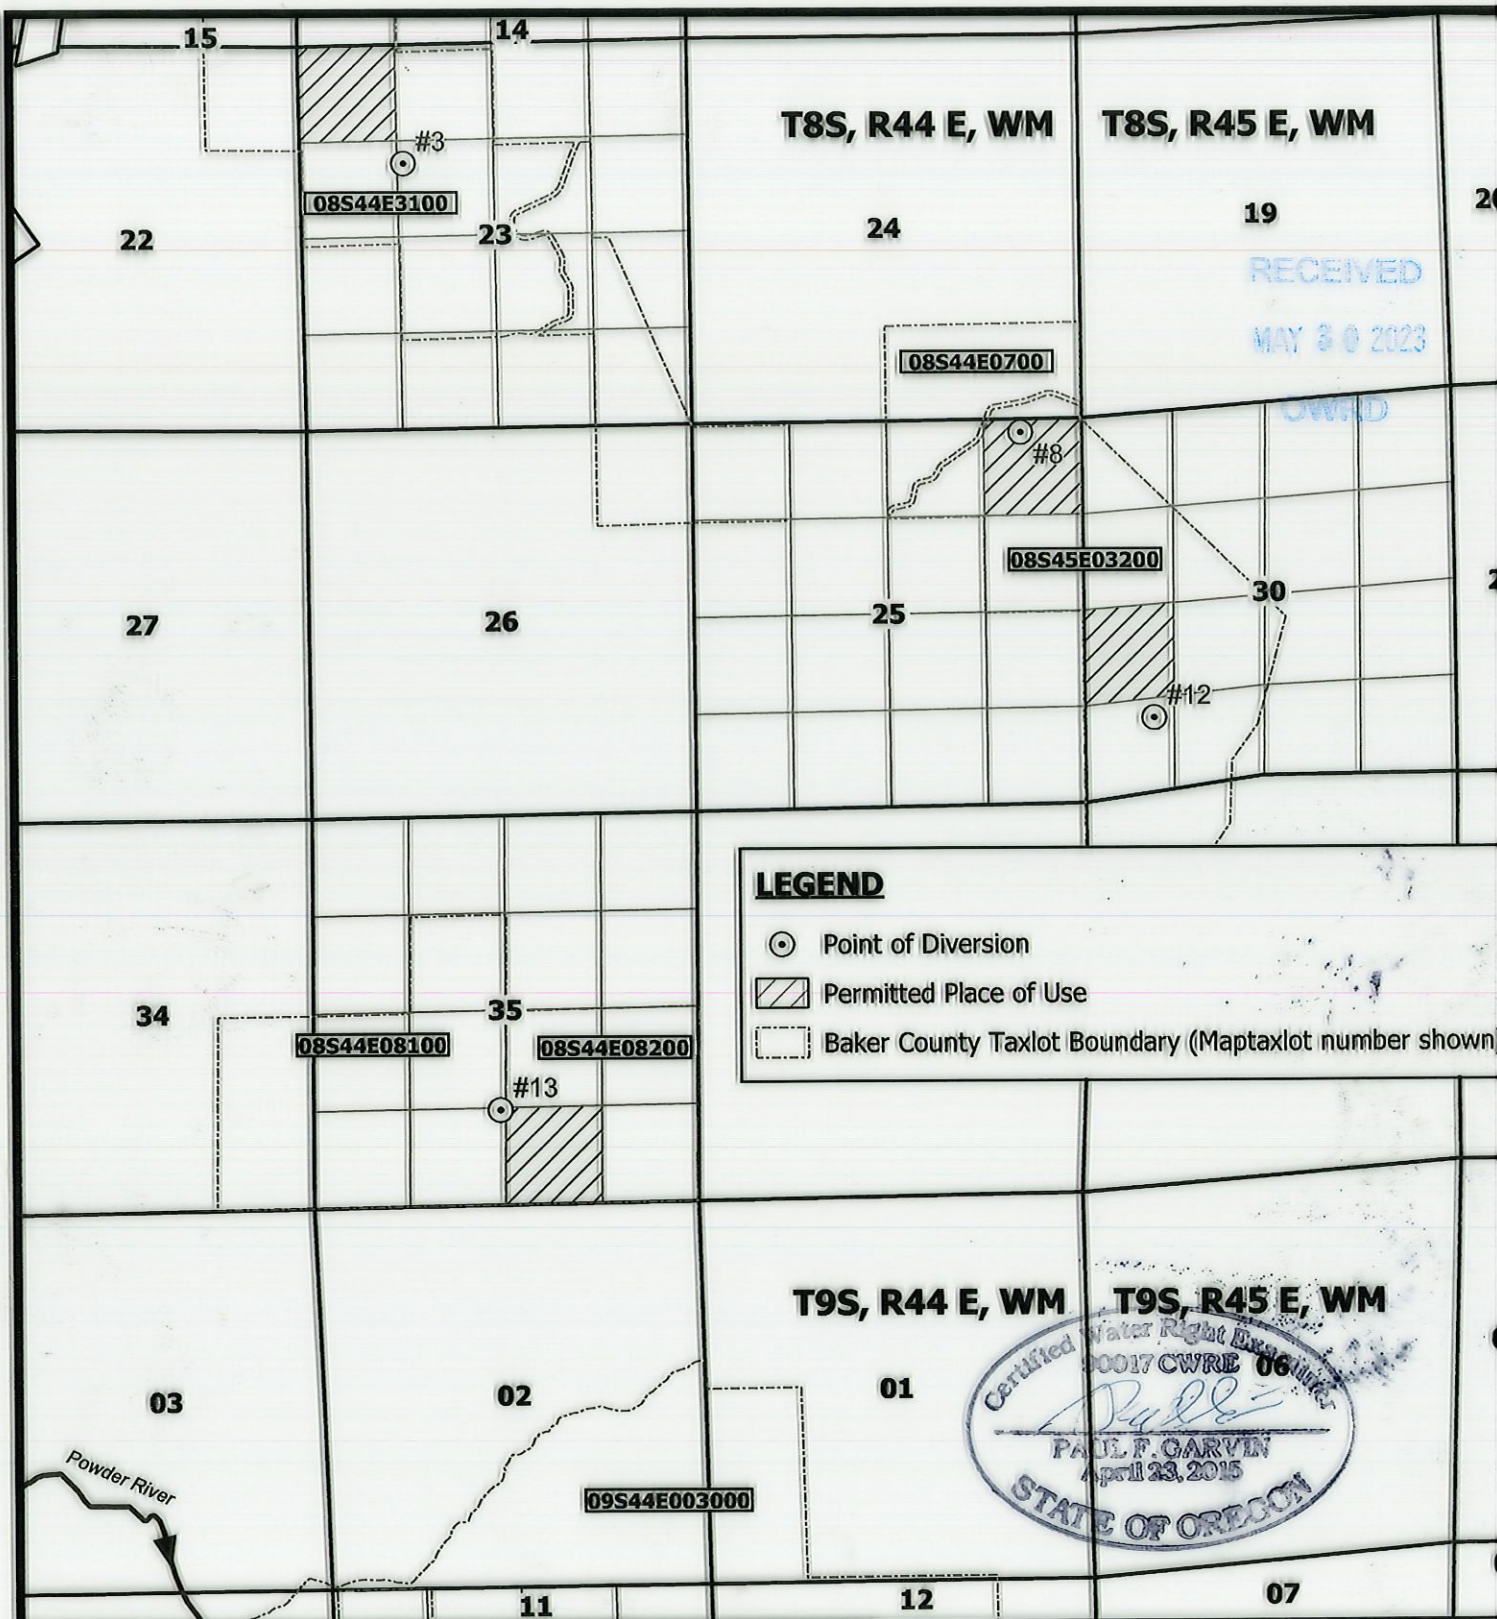

LEGEND

- ⊙ Point of Diversion
- ▨ Permitted Place of Use
- Baker County Taxlot Boundary (Maptaxlot number shown)



Claim of Beneficial Use Map (1 of 2) Application S-71211, Permit S-52451 Baker County, OR

Prepared on behalf of Fred Phillips

1 inch = 0.5 mile



Notes:


- Spring #3: 1,520' S and 1,400' E from the NW Corner of Section 23
- Spring #8: 840' W and 185' S from the NE Corner of Section 25
- Spring #12: 920' E and 1,020' N from the SW Corner of Section 30
- Spring #13: 2,550' E and 1,314' N from the SW Corner of Section 35

This map is not intended to provide legal dimensions or locations of property ownership lines.

RECEIVED

MAY 30 2023

OWRD

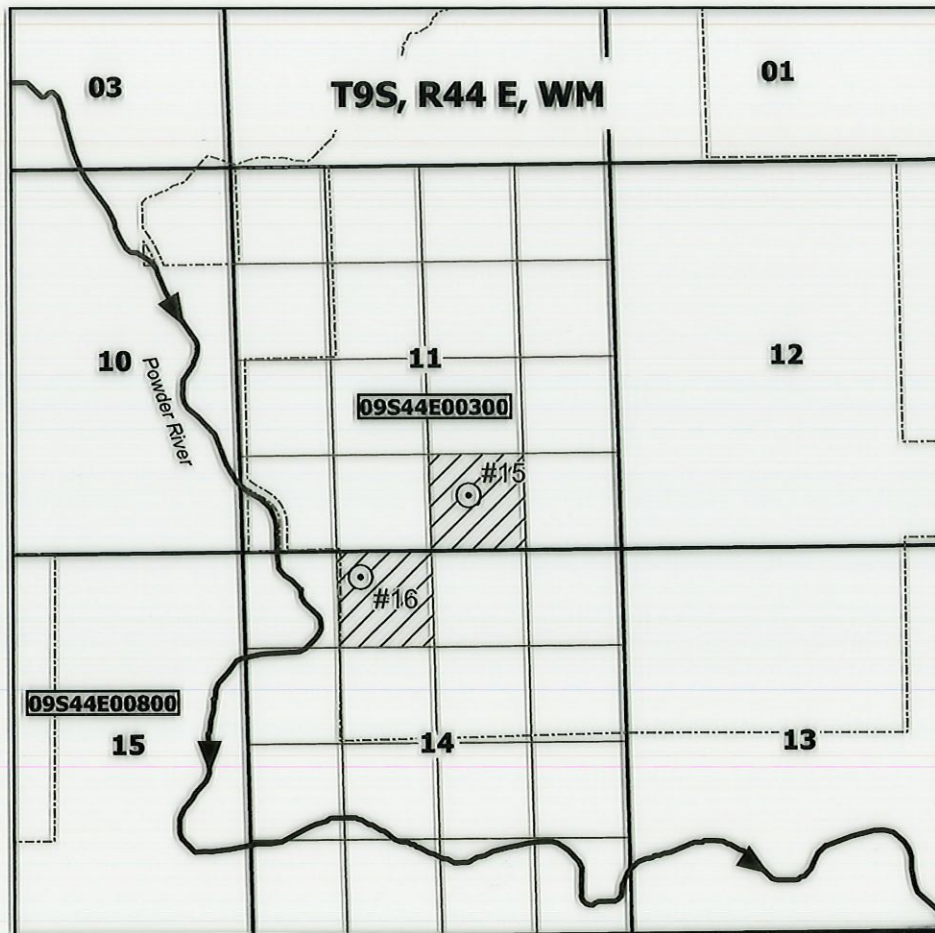

LEGEND

- ⊙ Point of Diversion
- ▨ Permitted Place of Use
- ▭ Baker County Taxlot Boundary (Maptaxlot number shown)



Date: 5/25/23
Drawn by: Paul F. Garvin

Claim of Beneficial Use Map (2 of 2) Application S-71211, Permit S-52451 Baker County, OR

Prepared on behalf of Fred Phillips

1 inch = 0.5 mile



Notes:

Spring #15: 2,040' W and 760' N from the SE Corner of Section 11
Spring #16: 1,600' E and 350' S from the NW Corner of Section 14

This map is not intended to provide legal dimensions or locations of property ownership lines.