


WELL LOCATIONS FROM  
CENTER OF SEC 35


#1	326' S,	609' W
#2	30' S,	1229' W
#3	35' S,	662' W
#4	347' S,	609' W

BASED ON W.C. SURVEY  
2020-003 TO SET C44, SEC 35

TAX LOTS 100 & 1701 OWNED BY  
WALLOWA CO. HEALTH CARE DIST.

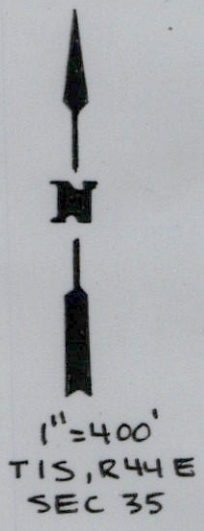

RECEIVED  
JUN 20 2023  
OWRD

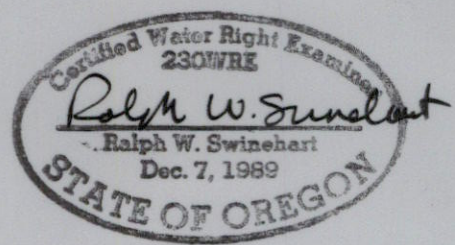

THIS MAP IS PREPARED FOR  
WATER RIGHT PURPOSES ONLY  
AND SHOULD NOT BE USED FOR  
PROPERTY LOCATION PURPOSES

FINAL PROOF SURVEY MAP  
FOR APP G-116757  
PERMIT G-17639  
T15, R44E, SEC 35, W.M.  
WALLOWA COUNTY

WALLOWA CO. HEALTH CARE DIST.  
601 MEDICAL PARKWAY  
ENTERPRISE, OREGON 97828

PREPARED BY RALPH W. SWINEHART  
ENTERPRISE, OREGON