
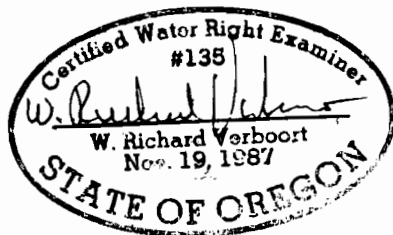


RECEIVED

MAR 09 1995
WATER RESOURCES DEPT
2 SALEM, OREGON

SECTION 34, T.2N., R.2W., W.M.
WASHINGTON COUNTY OREGON

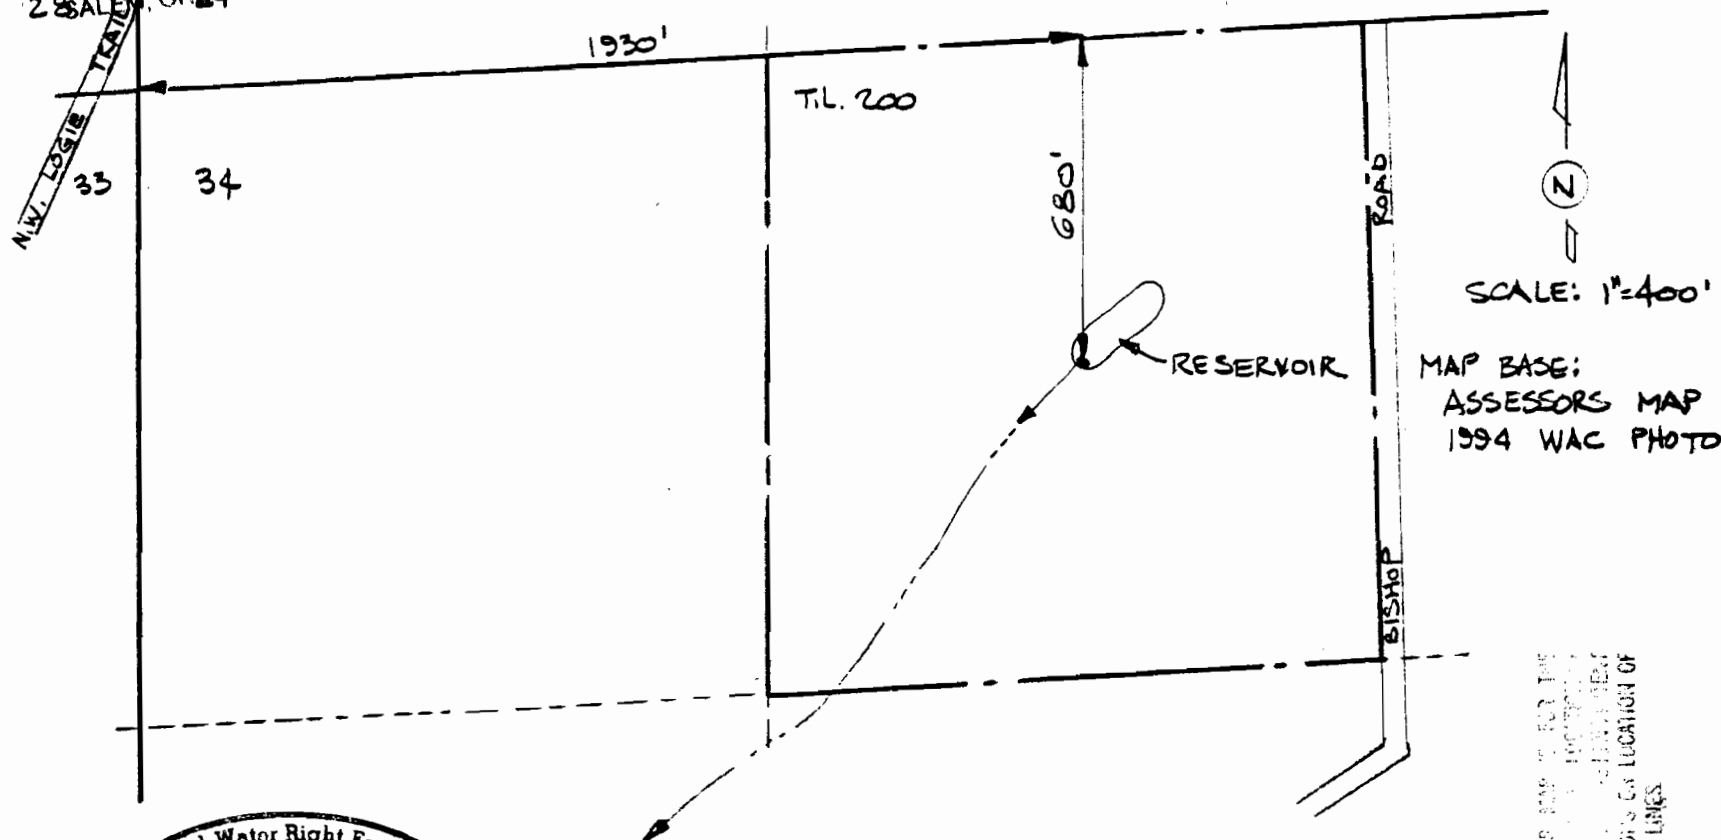

FINAL PROOF SURVEY

UNDER

APPLICATION R-70441

PERMIT R-11419

SURVEYED 2/28/95

PREPARED BY THE ENGINEER FOR THE
PURPOSE OF THE PROPOSED WATER
RIGHTS APPLICATION. THE ENGINEER
HAS CONDUCTED A VISUAL INSPECTION
TO PROVIDE A GENERAL LOCATION OF
PROPERTY OWNERSHIP LINES.

PAULE L. LOTTIN & MARK A. RAUCH

13707 BISHOP ROAD
HILLSBORO, OR 97124

designed	drawn	checked	drawing no.	sheet no.
WRV 2-95	JER 3-95	WRV 2-95	95-A-02	1/1

VERBOORT ENGINEERING

AGRICULTURE-CIVIL-WATER RESOURCES

HILLSBORO, OREGON