


**Claim of Beneficial Use**  
**Permit S-46551, Application S-62429**

A Water Right held by David Leff  
Coos County

RECEIVED

JUL 03 2023

OWRD

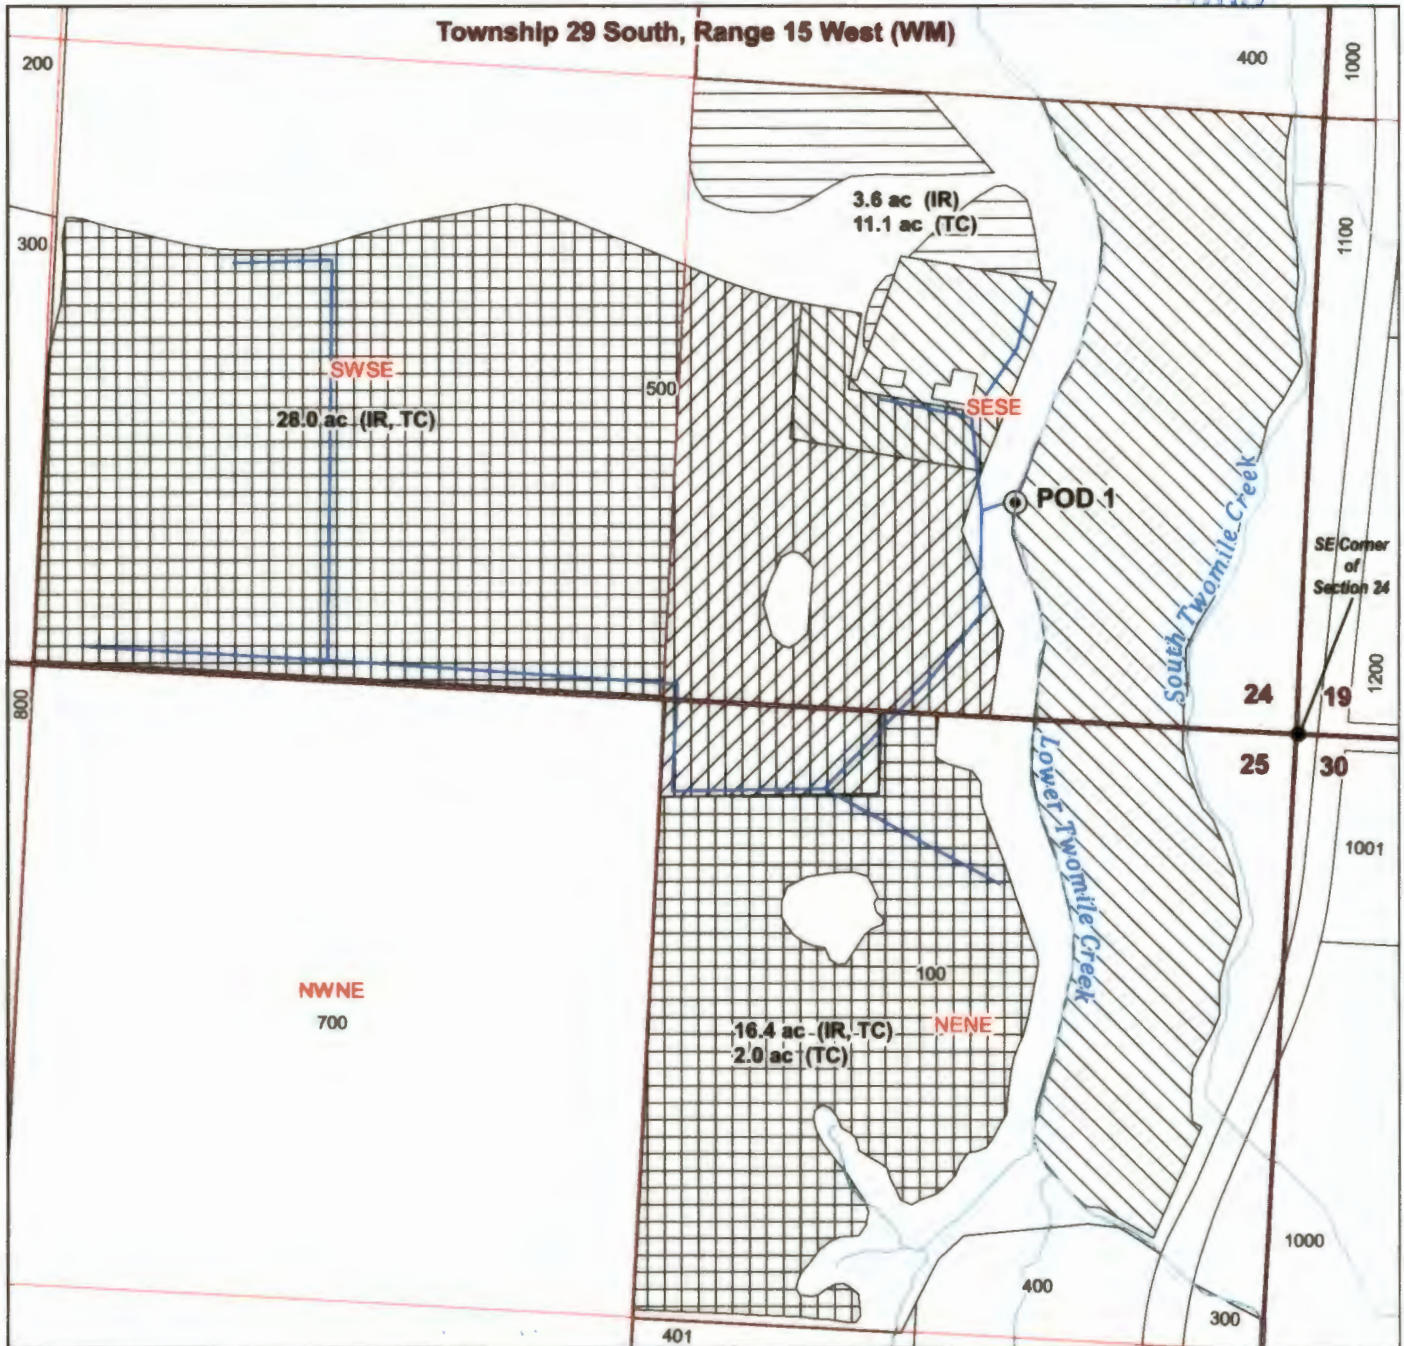


**LEGEND**

- Point of Diversion (POD)
- Place of Use (POU), Permit S-46551 (IR)
- POU, Permit S-46551 (TC)
- POU, Permit S-46551 (IR, TC)
- POU, Certificate 50470
- POU, Certificate 21883
- Property Lines
- Streams
- Conveyance Mains


**POA Location Description**

**POD 1**  
Located 450 feet North and 600 feet West from SE corner of Section 24 (SESE), Township 29 South, Range 15 West, WM

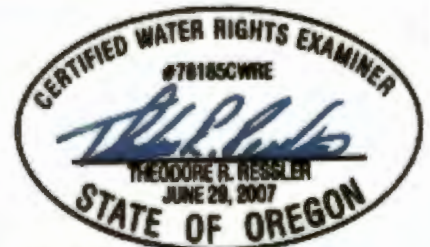

RENEWS: 12-31-2024

CWRE Seal and Signature

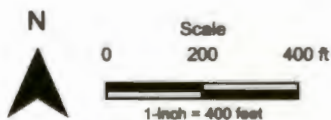

Date: 6/2/2023  
Data Sources: BLM, OWRD, USGS, Coos County.  
Disclaimer: This map is not intended to provide legal dimensions or property ownership lines.

