


T.7S. R.1E., W.M.

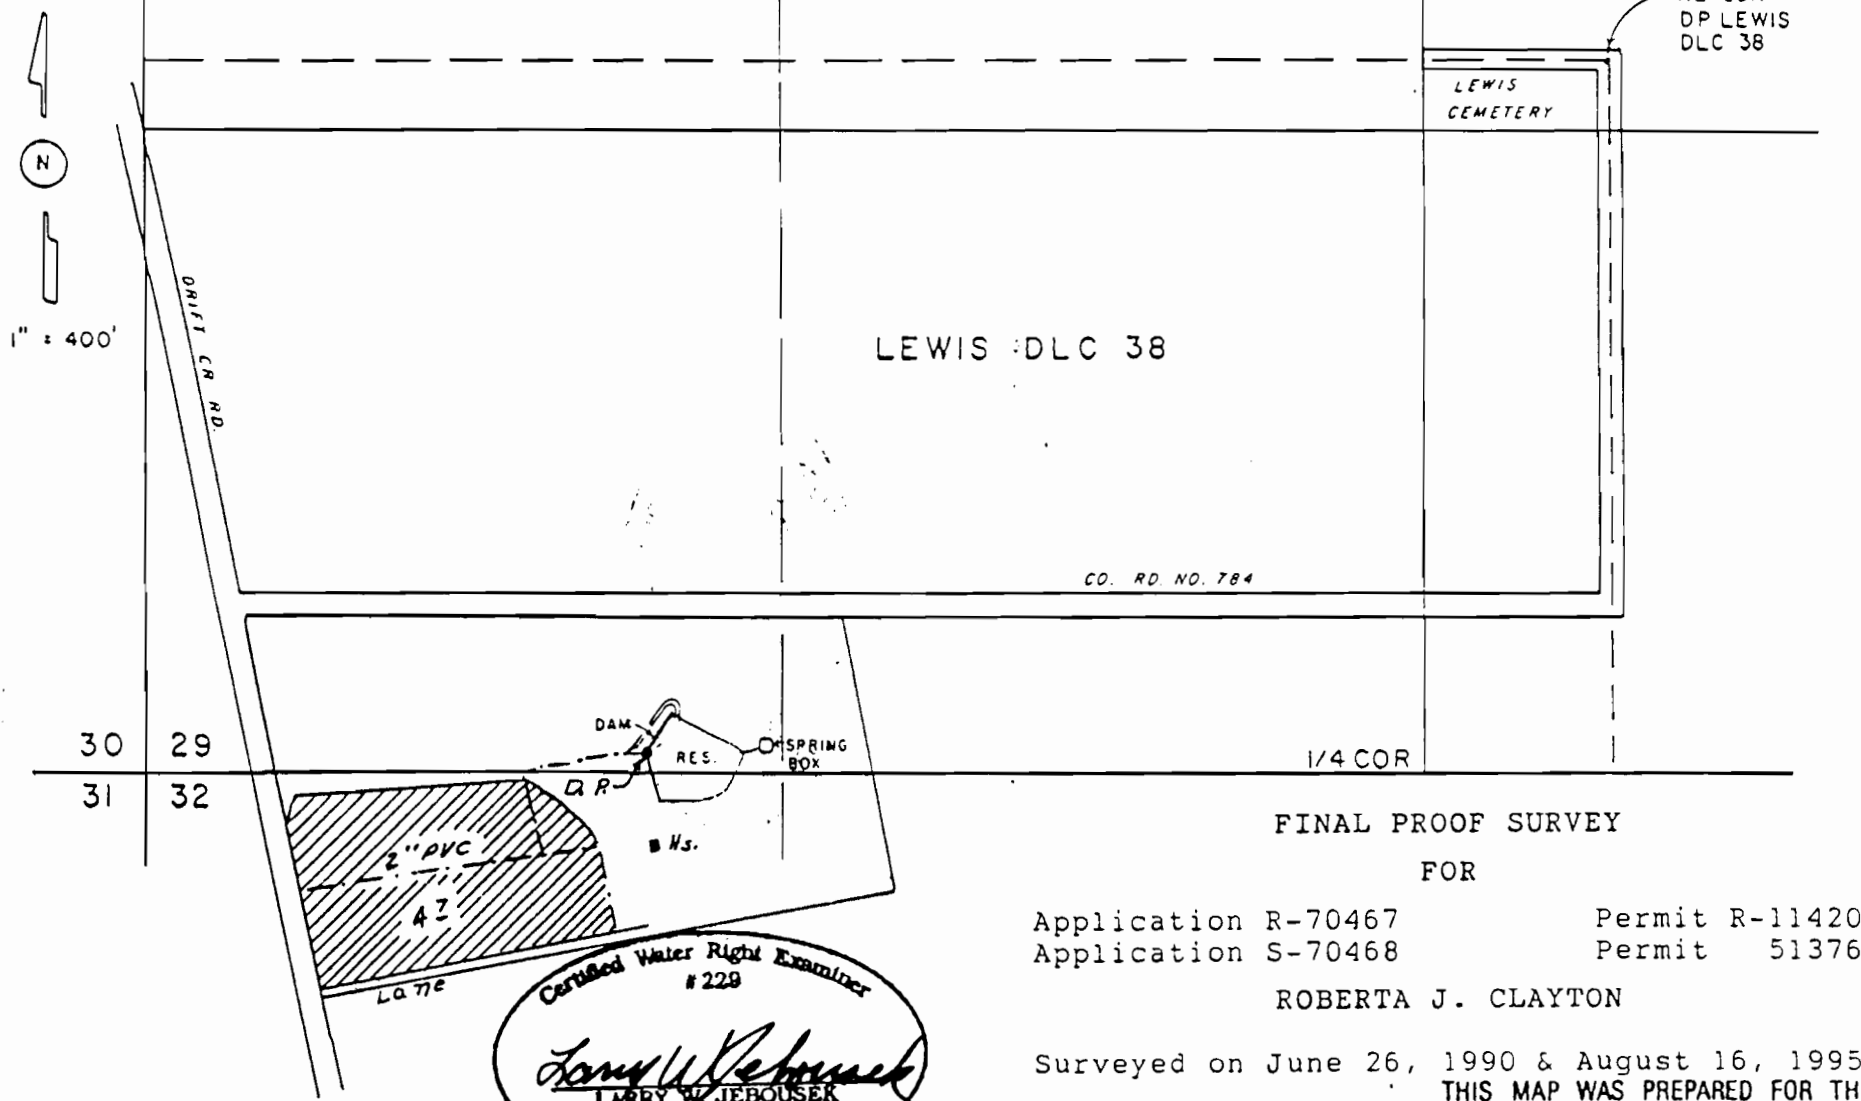


FINAL PROOF SURVEY
FOR

Application R-70467
Application S-70468

Permit R-11420
Permit 51376

ROBERTA J. CLAYTON

Surveyed on June 26, 1990 & August 16, 1995
THIS MAP WAS PREPARED FOR THE
PURPOSE OF IDENTIFYING THE LOCA-
TION OF A WATER RIGHT ONLY AND IS
NOT INTENDED TO PROVIDE LEGAL
DIMENSIONS OR LOCATION OF PROPER-
TY OWNERSHIP LINES.

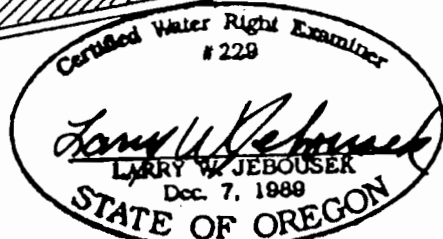

Diversion Point loc: 1,425' S & 2,000' W from NE Corner D.P. Lewis DLC 38