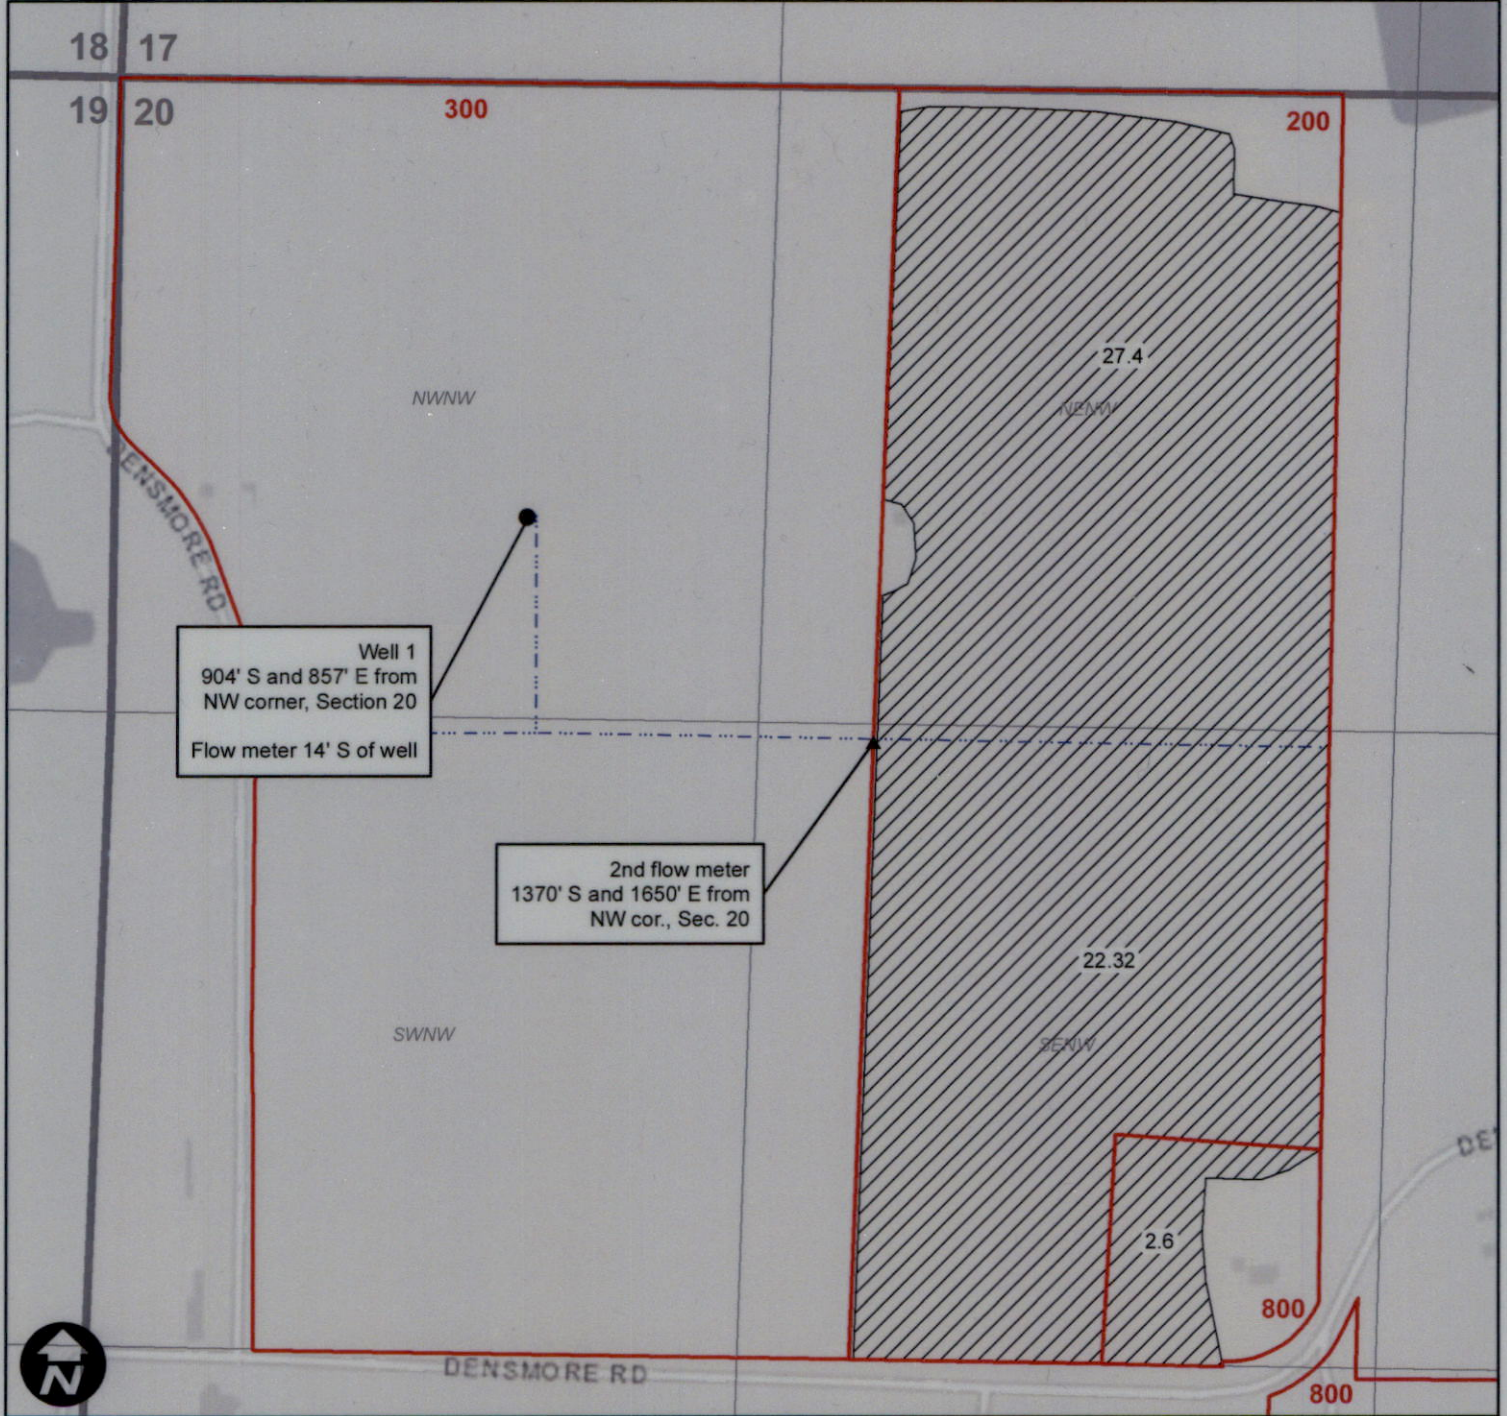


# Claim of Beneficial Use - K2A Properties LLC

Application G-18818, Permit G-18486

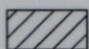
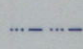
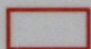
Township 10S, Range 2W, W.M.



0 200 400 800 Feet

This map is not intended to provide legal dimensions or locations of property ownership lines.

## Legend

 POU  Mainline  Taxlots

RECEIVED  
JUL 07 2023  
OWRD

CERTIFIED WATER RIGHT EXAMINER  
30680  
*William E. McGill*  
WILLIAM E. MCGILL  
MAY 3, 2011  
STATE OF OREGON  
EXPIRES: 12-31-2024