


Claim of Beneficial Use - Cala Farms

Application G-16930, Permit G-16413

Township 13S, Range 3W, W.M.

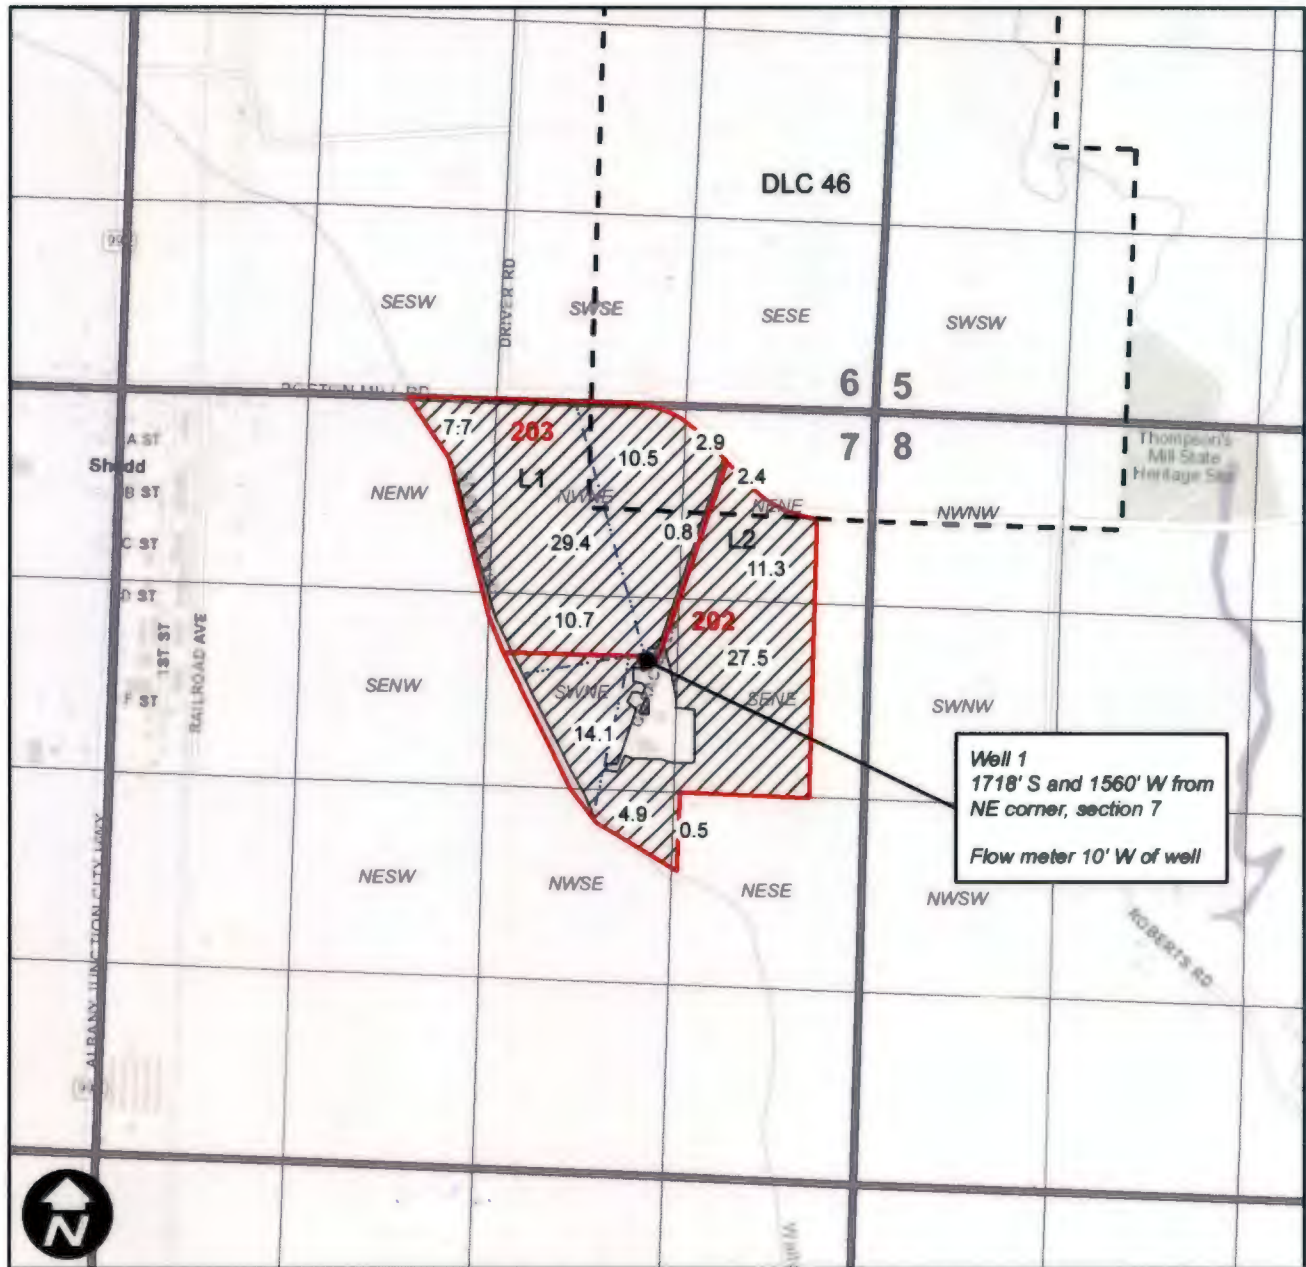


This map is not intended to provide legal dimensions or locations of property ownership lines.



Legend

-  POU
-  Taxlots
-  Mainline
-  DLC

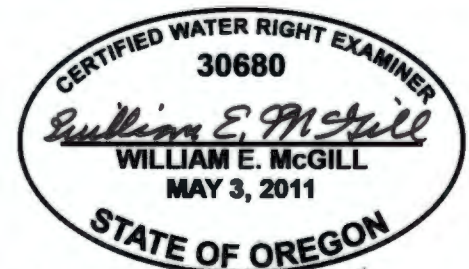

EXPIRES: 12-31-2024