


# Swallowtail School - Claim of Beneficial Use Application R-88684, Permit R-15397

Township 1N, Range 3W, Section 25, W.M.

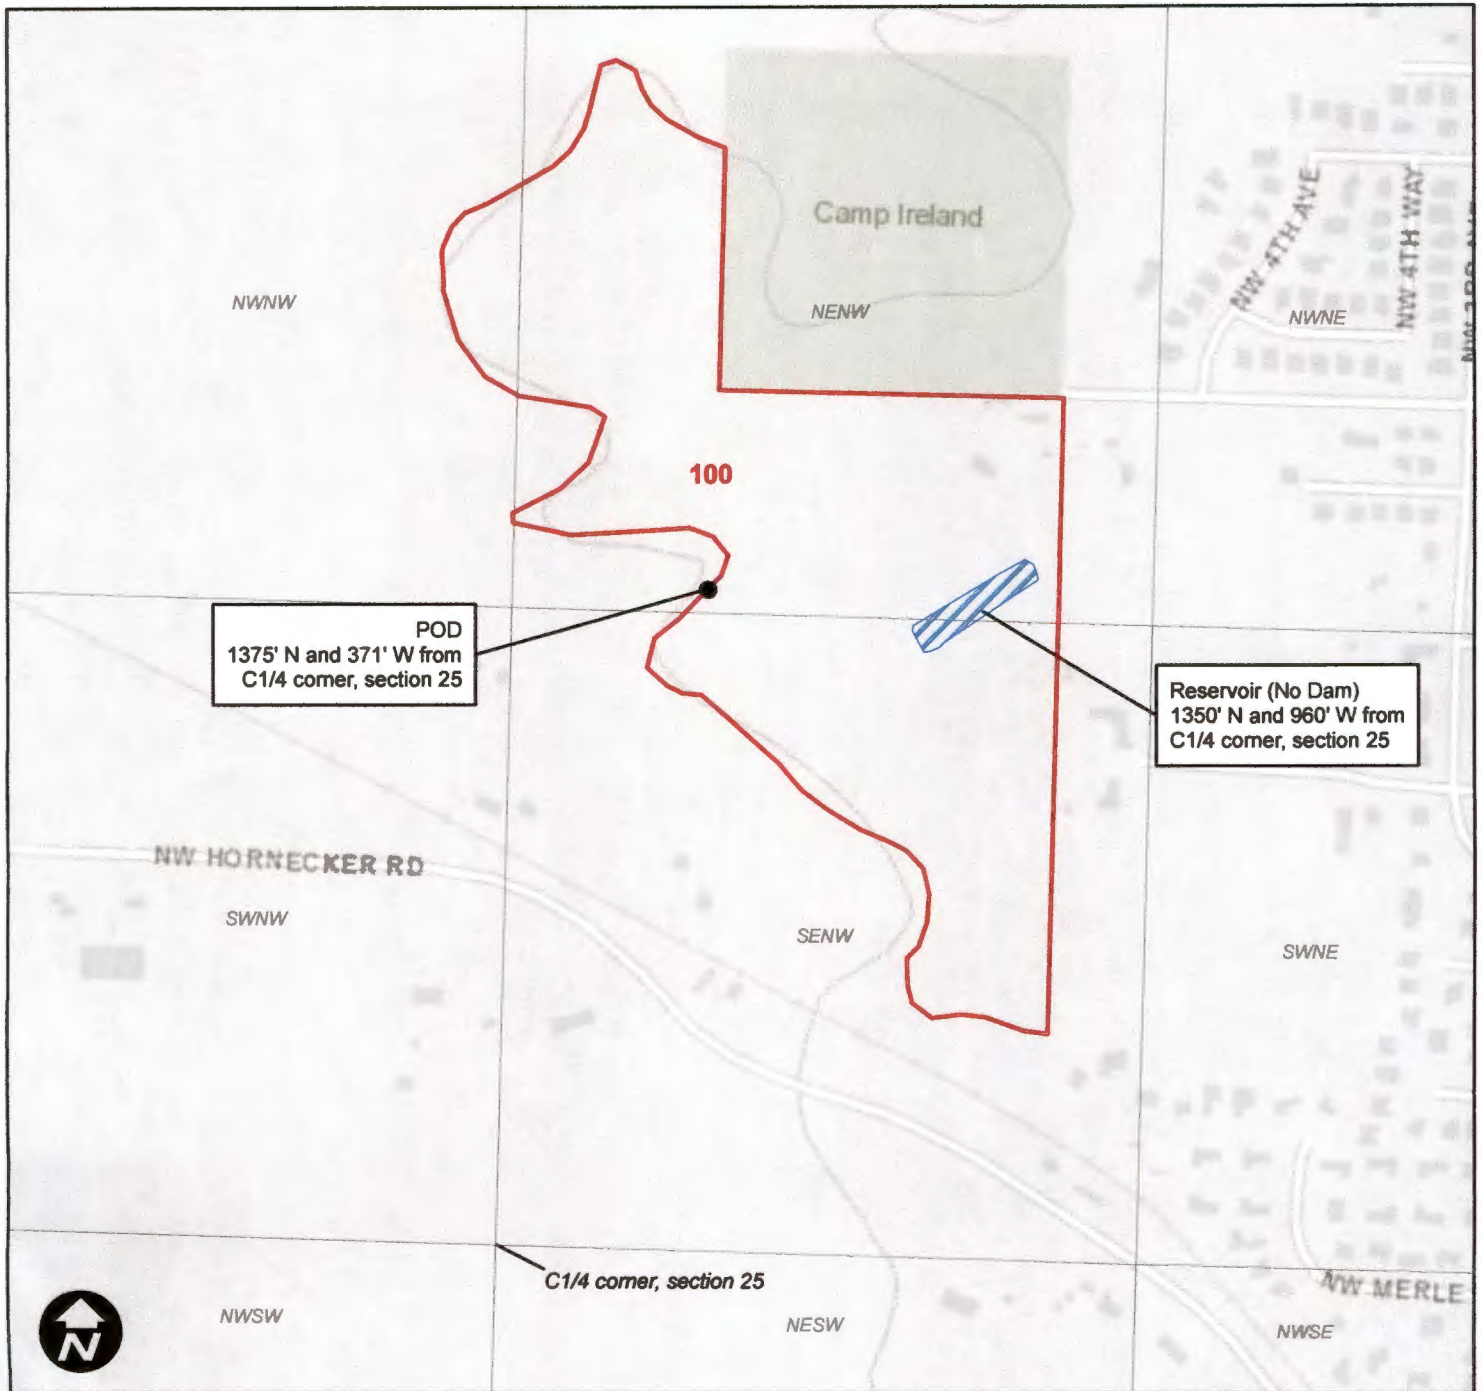

## Legend

 Reservoir  Taxlot

0 200 400 800 Feet

RECEIVED  
JUL 07 2023  
OWRD