

RECEIVED

JUL 10 2023

OWRD


APR 10 2023
(MAILED)

THIS MAP WAS PREPARED FOR
ASSESSMENT PURPOSE ONLY.


SE1/4 SEC.21 T.26S. R.5W. W.M.
DOUGLAS COUNTY
1" = 200'

REVISED ON
9-23-20

26 5 21C

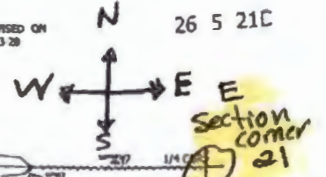

CANCELLED
1401 1301

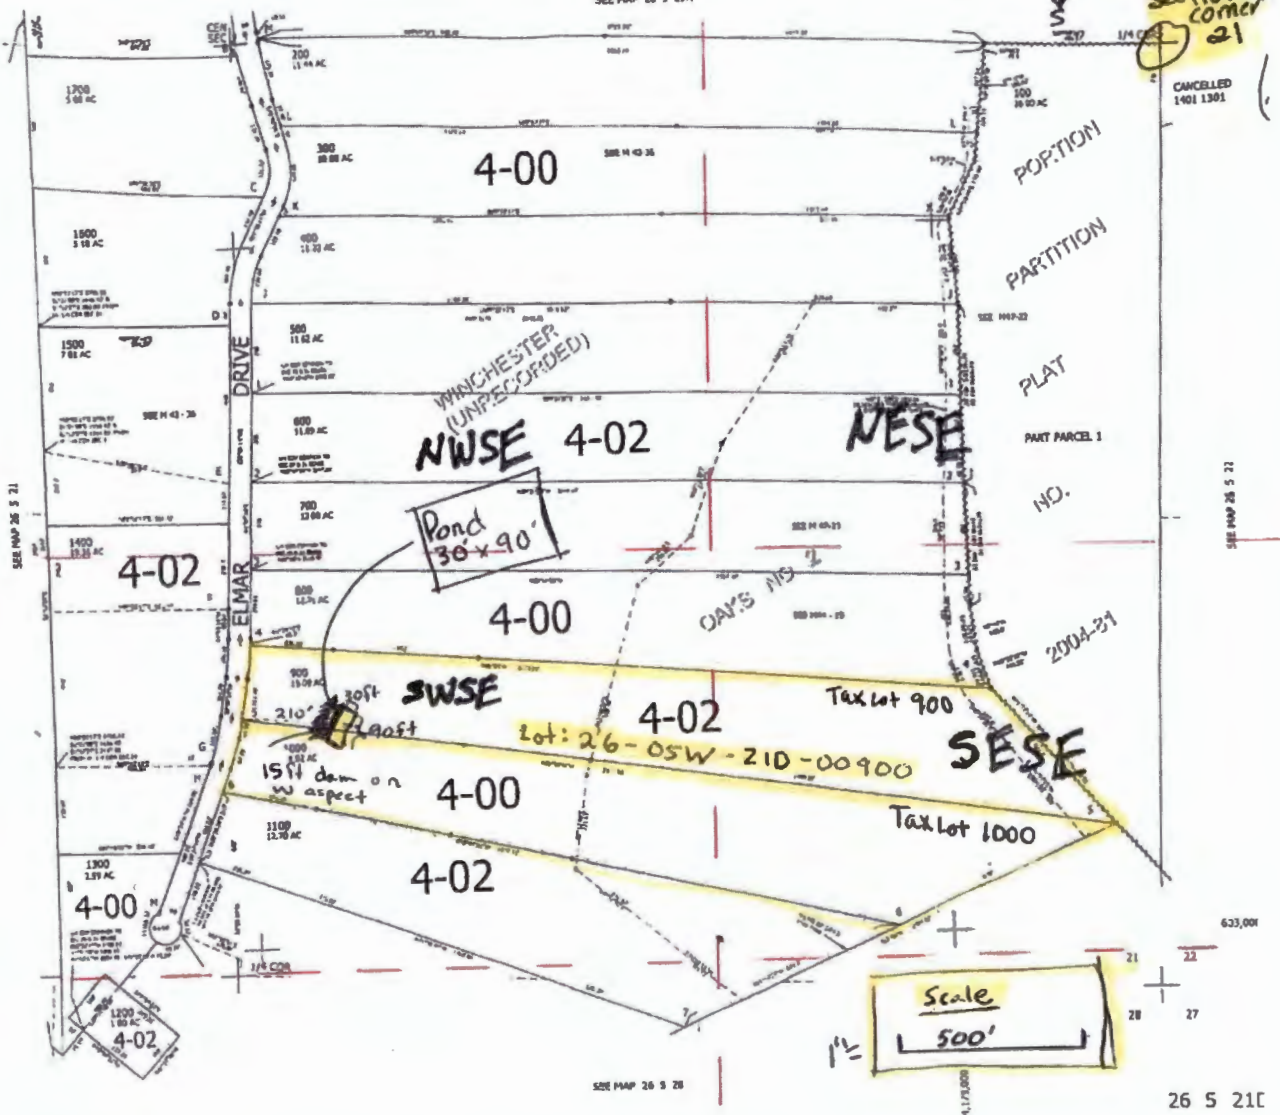

* Location:

QQ Lines

Pond is 1879 ft South and 2376 ft west
from the East 1/4 section corner 21